
FORM 51 25M 8-50 WESTERN . Scott KANSAS

Section 19 Township 18 Range 31W

Well No. #1 Chance

Company Herndon Drlg.

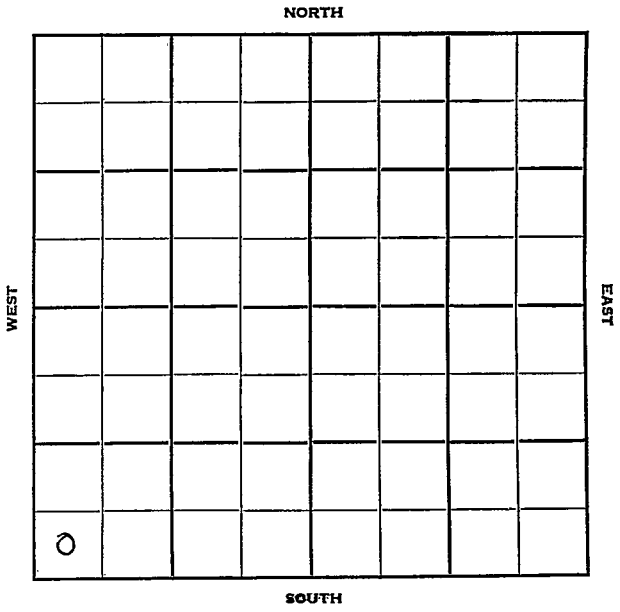

FORM 252-B
10M 10-50 PETROL

Scott KANSAS

Sec. 19 Twp. 18 R. 31W

Well No. #1 Chance Farm

Herndon Drlg. Company

Contractor

Keystone Pool


Ft. from N. Line

330' Ft. from S. Line

Ft. from E. Line

330' Ft. from W. Line

SW SW SW

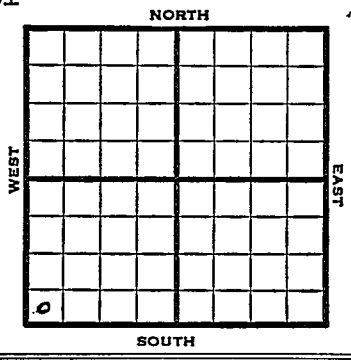

1951	Elev. 2971' REPORT
1/24	Spud 1-17-51 8" @ 287 Drlg. 2535'
3/21	Spud 1-17-51 Oil Well TD 4012 8" @ 287 DST 2740-65 opn 50 min Rec. 30000 cfg DST 3908-32 opn 35 min. Rec. 30' mud Lans. 3874' DST 3954-78 opn ½ hr Rec. 1050' water DST 3998-4012 opn 45 min Rec. 335' oil TD 4012 5" @ 3998' 500 A 20 boph Comp 95 bopd 15% wtr. COMPLETED

FORM 275 FOR SALE BY KANSAS BLUE PRINT CO.


County Scott State Kansas

Sec. 19 (Blk. Twp.) 18 (Sur. Rge.) 31W Map No.

Operator Herndon Drlg.

Well No. 1 Farm Chance

Elev. 2971 Location SW SW SW

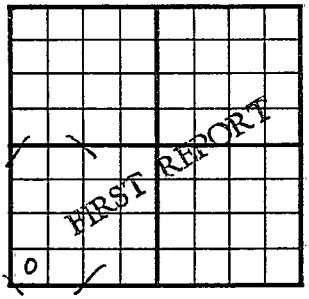

330 Ft. From S Line SW

330 Ft. From W Line Quarter

1st. Report JAN 24 1951

Completion

Remarks

Spudding Date 1-17-51

Drlg. Data Kaystone Pool

8" @ 287 drlg. 2535

J. E. TYRA

FORM 275 FOR SALE BY KANSAS BLUE PRINT CO.


County Scott State Kansas

Sec. 19 (Blk. / Twp.) 18 (Sur. / Rge.) 31W Map No.

Operator Herndon Drlg.

Well No. 1 Farm Chance

Elev. 2971 Location SW SW SW

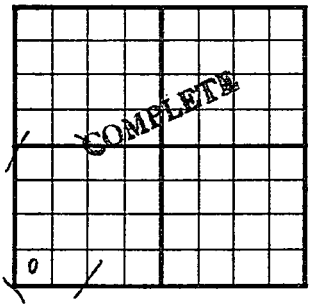

330 Ft. From S Line SW

330 Ft. From W Line Quarter

1st. Report

Completion MAR 21 1951

Remarks Keystone Pool

Spudding Date 1-17-51

Drlg. Data Oil well TD 4012

8" @ 287 DST 2740-65 open 50 min.

Rec. 30000 cfg DST 3908-32 open 35 min.

Rec. 30' mud Lans. 3874 DST 3954-78

open ½ hr. Rec. 1050' water DST 3998-401

4012 open 45 min. Rec. 335' oil

TD 4012 5" @ 3998 500 A 20 boph

Comp. 95 bopd 15% water

J. E. TYRA