


Section 30 Township 18 Range 31 W

Well No. # 1 Chance "A"

Company Herndon Drlg.

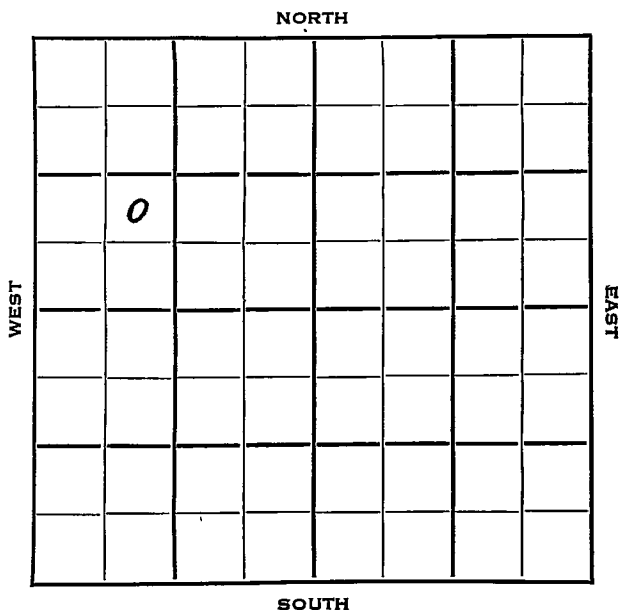

Scott

FORM 252-B

KANSAS ✓

Sec. 30 Twp. 18 R. 31W

Well No. #1 Chance "A" Farm

Herndon Drlg. Company

Herndon Contractor

Keystone Pool


Ft. from N. Line

990 Ft. from S. Line

Ft. from E. Line

990 Ft. from W. Line

NE SW NW

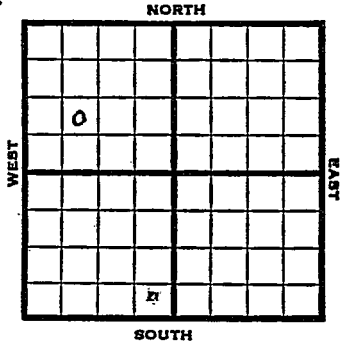

1953 Elev. 2971' REPORT

8/5 Spud 8-3-53

8/12 8" @ 373
Drlg. 2680'

8/19 Drlg.

9/2 Spud 8-3-53

D&A

TD 5106

8" @ 373

Lans 3877

DST 4006-30, opn 2 hrs., rec. 325'
sw, 910#

DST 4109-32, opn 2 hrs., rec. 20'
hocm, 130' sw, 930#

DST 4166-80, opn 3/4 hrs., rec. 30'
ocsw, 540' blk sul wtr., 1020#

B KC 4291, Miss 4531

DST 4520-87, opn 3/4 hrs., rec. 30'
mud, 250#

Viola 5000

DST 5002-16, opn 1 hr., rec. 2100'
sw, 1350#

Arb. 5049

TD 5106

D&A

ABANDONED

County Scott State KANSAS

Sec. 30 (Blk.) 18 (Sur.) 31W Map No.

Operator Herndon Drlg.

Well No. 1 Farm Chance "A"

Elev. Location NE SW NW

| | | | | | |
|---|--|--|--|--|--|
| | | | | | |
| | | | | | |
| 0 | | | | | |
| | | | | | |
| | | | | | |
| | | | | | |
| | | | | | |
| | | | | | |

990 Ft. From S Line NW

990 Ft. From W Line Quarter

1st. Report 416 5 1953

Completion

Remarks

Herndon - Contr.

Spudding Date 8-3-53

Drlg. Data Keystone Pool

FIRST REPORT

