
Cowley

FORM 51 25M 3-49 PETROL KANSAS

Section 1 Township 32 Range 3-E

Well No. #1 Groene - Rahn

Company Bufflow Oil et al

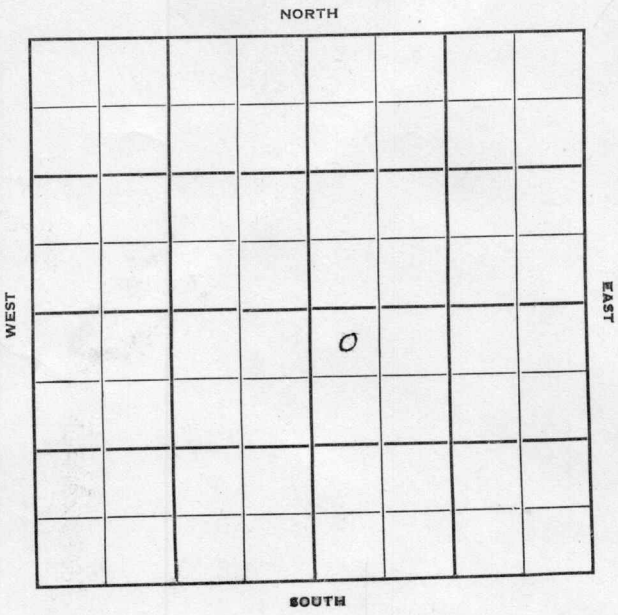

FORM 252-B
10M 9-49 PETROL

Cowley KANSAS

Sec. 1 Twp. 32 R. 3E ✓

Well No. #1 Groene - Rahn Farm

Bufflow Oil et al Company

Watson- Contr. Contractor

Wildcat


330' Ft. from N. Line

Ft. from S. Line

Ft. from E. Line

330' Ft. from W. Line

NW NW SE

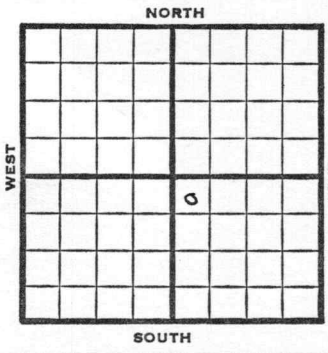

1950	Elev 1132 REPORT
10/18	Location
11/8	8" @ 96
	Iton 1990 Stal 2000
	KC 2435 Miss 3027
	Simp 3355 Arb 3360
	TD 3375
	D&A
	ABANDONED

FORM 275 FOR SALE BY KANSAS BLUE PRINT CO.


County Cowley State Kansas

Sec. 1 (Blk. Twp.) 32 (Sur. Rge.) 3E Map No.

Operator Bufflow Oil etal.

Well No. 1 Farm Groene - Rahn

Elev. Location NW NW SE

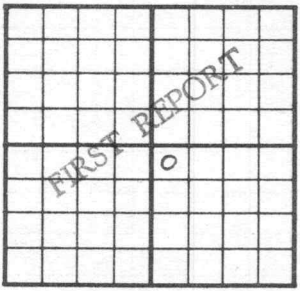

330 Ft. From N Line SE

330 Ft. From W Line Quarter

1st. Report OCT 18 1950

Completion

Remarks

Watson - Contr.

Spudding Date

Drlg. Data Wildcat

Location

J. E. TYRA

FORM 275 FOR SALE BY KANSAS BLUE PRINT CO.


County Cowley State Kansas

Sec. 1 (Blk. Twp.) 32 (Sur. Rge.) 3E Map No.

Operator Bufflow Oil etal.

Well No. 1 Farm Groene - Rahn

Elev. 1132 Location NW NW SE

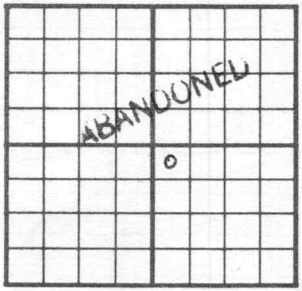

330 Ft. From N Line SE

330 Ft. From W Line Quarter

1st. Report

Completion NOV 8 1950

Remarks Wildcat

Watson - Contr.

Spudding Date

Drlg. Data D & A TD 3375

8" @ 96 Iton 1990 Stal. 2000

KC 2435 Miss 3027 Simp. 3355

Arb. 3360 TD 3375

D & A

J. E. TYRA