

Map No. _____ Sec. 7 Twp. 27 R. 9Well No. 2 Stewart FarmEmpire Company

NORTH

WEST

EAST

COMPLETED

SOUTH

Location _____

Rig Up _____

Drilling Remarks:

Drilling Remarks:

RECORD

Cased _____ in. _____ ft.

Sand _____

Gas _____

Oil _____

Total Depth _____

PRODUCTION

1st 24 hrs. Nat. _____

1st 24 hrs. after shot _____

Gas _____ cu. ft.

Dry Hole _____

Abandoned _____


Map No. K10 Sec. 7 Twp. 27 R. 9Well No. 2 Stewart
Empire G.F. Company

Contractor

NORTH

WEST

EAST

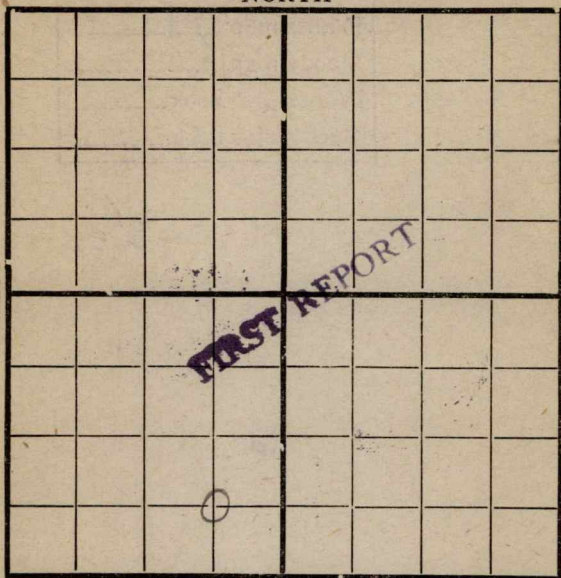

660 S-E SOUTH

Location _____

Rig up _____

Drilling and Remarks:

Spudding

RECORD

Cased _____ in., _____ ft.

Sand _____

Gas _____

Oil _____

Total Depth _____

PRODUCTION

1st 24 hrs. Nat. _____

1st 24 hrs. after shot _____

Gas _____ Cu. Ft.

Dry Hole _____

Abandoned _____

Date


5/7 1919 Cyle Scout

Map No. K10 Sec. 7 Twp. 27 R. 9
 Well No. 2 Stewart
Empire Company
 Contractor

NORTH

WEST

EAST

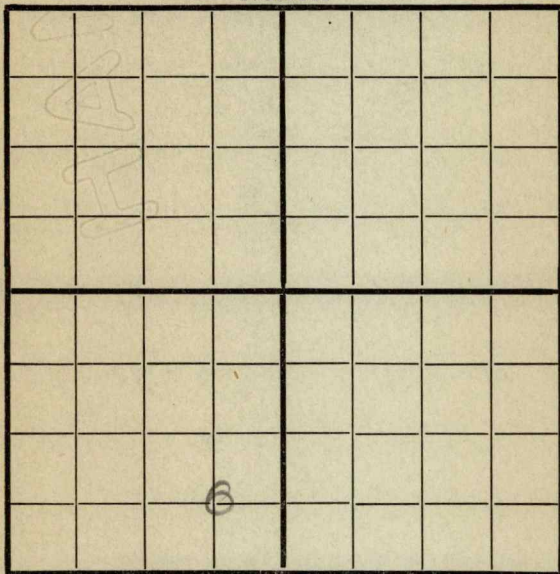

SOUTH

6605-E

Location _____

Rig up _____

Drilling and Remarks:

1000'

RECORD

Cased _____ in., _____ ft.

Sand _____

Gas _____

Oil _____

Total Depth _____

PRODUCTION

1st 24 hrs. Nat. _____

1st 24 hrs. after shot _____

Gas _____ Cu. Ft.

Dry Hole _____

Abandoned _____

Date

5/18

1919

Oyle


Scout

Map No. K10 Sec. 7 Twp. 27 R. 9
 Well No. 2 Stewart
Empire Company
 Contractor

NORTH

WEST

EAST

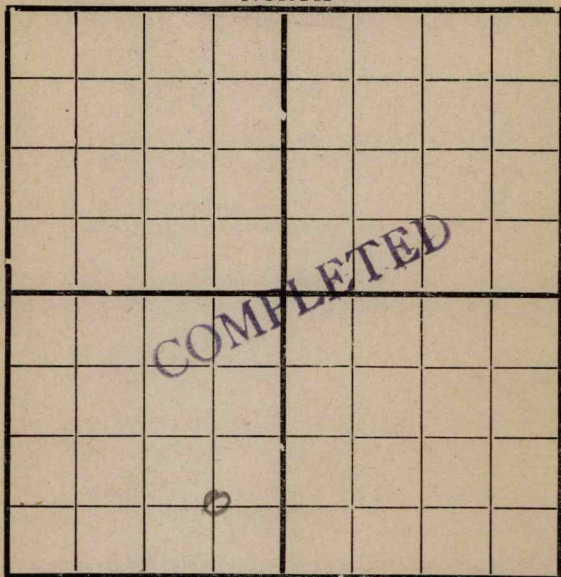

SOUTH

6605.E

Location _____

Rig up _____

Drilling and Remarks:

RECORD

Cased _____ in., _____ ft.

Sand 1084 - 1114

Gas _____

Oil _____

Total Depth _____

PRODUCTION

1st 24 hrs. Nat. _____

1st 24 hrs. after shot _____

Gas 2 million Cu. Ft.

Dry Hole _____

Abandoned _____

Date

5/29 1919

Pyle

Scout