


Section 25 Township 18 Range 33rdWell No. #1 V. M. HarrisCompany Shallow Water Ref.

NORTH

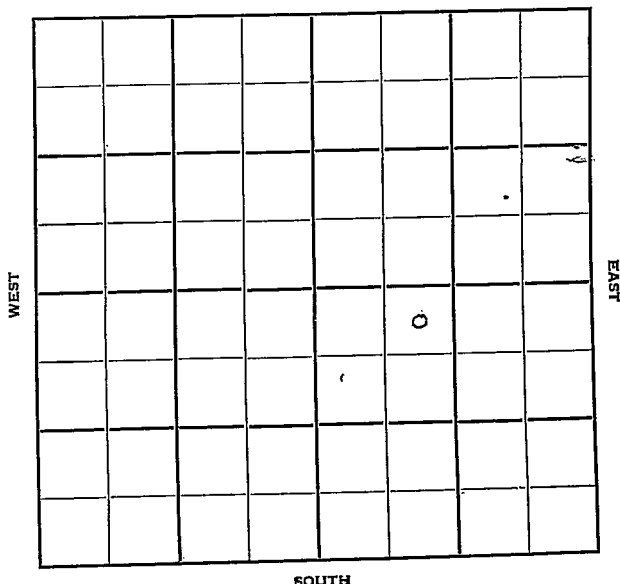

Scott

KANSAS

33W

Sec. 25 Twp. 18 R. 33W

Well No. #1 V.M. Harris Farm

Shallow Water Ref. Company

Harbar Contractor

Wildcat


330' Ft. from N. Line

Ft. from S. Line

Ft. from E. Line

990' Ft. from W. Line

NE NW SE

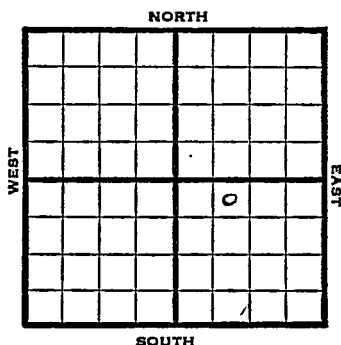

1950

Elev 2954

REPORT

5/3 Spud 4-20-50
10-3/4" @ 270'
Drlg. 4000'

5/17 TD 4775
10 3/4" @ 270
Herrington 2715
Lans 3910
Miss 4708-95 TD
D&A

ABANDONED

O. W. D. D

6/7 T.D. 4795
5 1/2" @ 4783
Glena out to 4795
7 bl bluid p.h.
mostly wtr

7/26 TD 4795
5 1/2" @ 4783
SP 4755
2000 acid
S/wtr
80/4665-85
1000 acid
test 4 boph
4000 acid, 1500 acid, 3000 acid
TD 4949
D&A

ABANDONED

Kansas

Wildcat

Map No. _____ Sec. 25 Twp. 18 R. 33WWell No. 1 V. M. Harris

_____ Shallow Water Ref. _____ Company

_____ Harbar _____ Contractor

NE NW SE


SECTION PLAT

330

_____ Ft. from N. Line

_____ Ft. from S. Line

_____ Ft. from E. Line

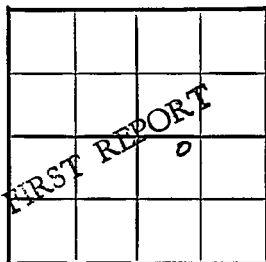990 Ft. from W. LineScott County

Location _____

Rig up _____

Drilling and Remarks:

Spud 4-20-50

10 3/4" @ 270

drlg. 4000

RECORD

Cased _____ in., _____ ft.

Sand _____

Gas _____

Oil _____

Total Depth _____

PRODUCTION

1st 24 hrs. Nat. _____

1st 24 hrs. after shot _____

Gas _____ Cu. Ft.

Dry Hole _____

Abandoned _____

Date

MAY 3 1950 19J. E. TYRA

Scout

Kansas

Map No. _____ Sec. 25 Twp. 18 R. 33WWell No. 1 V. M. Harris

Shallow Water Ref. _____ Company _____

_____ Contractor

NE NW SE


El. 2954

SECTION PLAT

330 Ft. from N. Line

_____ Ft. from S. Line

_____ Ft. from E. Line

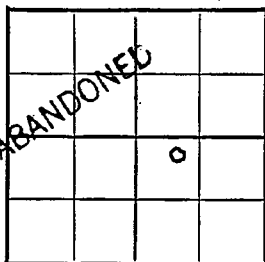990 Ft. from W. Line

Scott

Location _____

Rig up _____

Drilling and Remarks:

10 3/4' @ 270
Herrington 2715
Loss 3910
Miss 4708-95 T.D
A + A

RECORD

Cased _____ in., _____ ft.

Sand _____

Gas _____

Oil _____

Total Depth 4773

PRODUCTION

*1st 24 hrs. Nat. _____

1st 24 hrs. after shot _____

Gas _____ Cu. Ft.

Dry Hole _____

Abandoned _____

Date

MAY 17 1950

19

Scout

Map No. _____ Sec. 25 Twp. 18 R. 33W

Well No. 1 V. M. Harris

Shallow Water Ref. _____ Company _____

Contractor _____

NE NW SE

SECTION PLAT

330 Ft. from N. Line

_____ Ft. from S. Line

_____ Ft. from E. Line

990 Ft. from W. Line

FIRST REPORT			
		0	

Scott County

OWDD

Location _____

Rig up _____

Drilling and Remarks:

T. D. 4795

5 $\frac{1}{2}$ ' @ 4783

Clean out to 4795

7 bbl. fluid p. h.

Mostly water.

RECORD

Cased _____ in., _____ ft.

Sand _____

Gas _____

Oil _____

Total Depth _____

PRODUCTION

1st 24 hrs. Nat. _____

1st 24 hrs. after shot _____

Gas _____ Cu. Ft.

Dry Hole _____

Abandoned _____

Date

JUN 7 1950

19

J. E. TYRA Scout

Map No. _____ Sec. 25 Twp. 18 R. 33WWell No. 1 V. M. Harris

Shallow Water Ref. _____

Company _____

Contractor _____

NE NW SE

SECTION PLAT

330 Ft. from N. Line

_____ Ft. from S. Line

_____ Ft. from E. Line

990 Ft. from W. Line

		0	

Scott County

Location _____

Rig up _____

Drilling and Remarks:

TD 4795

5 $\frac{1}{2}$ " @ 4783

SP 4755

2000 acid

S/ water

80/ 4665-85

1000 acid

RECORD

Cased _____ in., _____ ft.

Sand _____

Gas _____

Oil _____

Total Depth 4948

PRODUCTION

1st 24 hrs. Nat. _____

1st 24 hrs. after shot _____

Gas _____ Cu. Ft.

Dry Hole _____

Abandoned _____

test 4 goph

Date

JUL 26 1950 19J. E. TYRA Scout

4000 acid
 1500 acid
 3000 acid
 TD 4948
 D & A

1950

_____	Misc.
_____	Pierce Map
_____	France Map
_____	Tracings
_____	Land Wall Map
_____	Land Small Map
_____	Scout Cards

APR 1 1950

