

Wichita


KANSAS

SECTION 33 TOWNSHIP 18 RANGE 36W

WELL NO. #1 Mantel

COMPANY Musgrove Petr.

NORTH

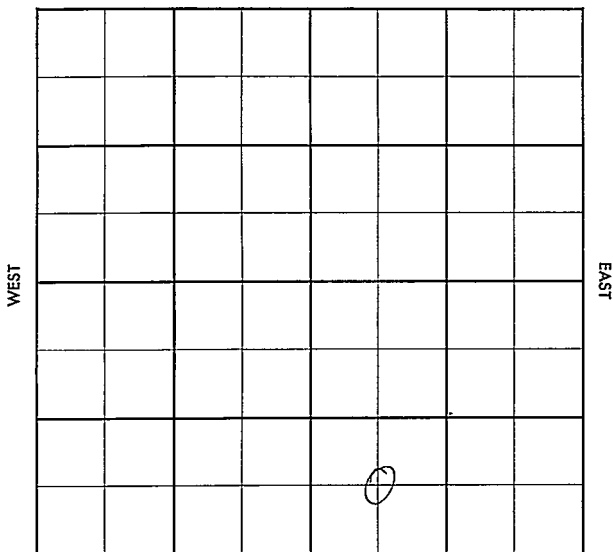

SOUTH

Wichita

KANSAS

SEC.

TWP.

R.

33

18

36W

WELL NO.

#1 Mantel

FARM

COMPANY

Musgrove Pet

CONTRACTOR

Wildcat


____ FT. FROM N. LINE

____ FT. FROM S. LINE

____ FT. FROM E. LINE

____ FT. FROM W. LINE

C SW SE

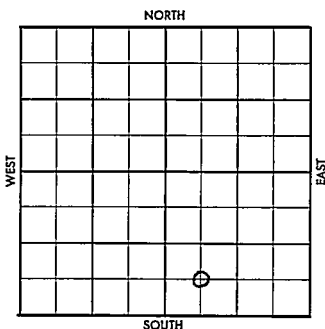

Vicker & PEPL - DHM

1956

ELEVATION

REPORT

9-12

Loc


County Wichita Elev. _____
Sec. 33 Twp. 18 Rge. 36W
Company Musgrove Pet.
Farm Name Mantel No. 1

TOPS	DEPTH	LOG	DATUM
Anh.			
Tr.			
H.			
Tr.			
Dg.			
BL.			
L.			
K.C.			
B.K.C.			
Ce.			
C.			
M.			
M.			
K.			
Mz.			
Mq.			
V.			
S.			
S.			
A.			
R.			
PE.			
G.			
T.D.			

Loc. in Sec. C SW SE
Geol. _____
Concr. _____
Pool Wildcat

FIRST REPORT
SEP 12 '50
0

Date Comm. Vicker & PEPL - DHM
Location _____

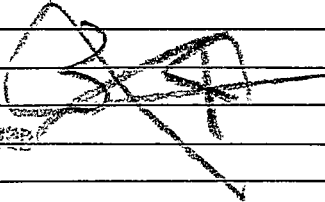

County Wichita Elev. 3264
 Sec. 33 Twp. 18 Rge. 36W
 Company Musgrove Pet.
 Farm Name Mantel No. 1

TOPS	DEPTH	LOG	DATUM	Loc. in Sec.
Anb.				C SW SE
TP. <u>Blaine</u>	<u>1565</u>			
H. <u>Anty</u>	<u>2704</u>			
Jr. <u>Well</u>	<u>2535</u>			
Dg. <u>Herr</u>	<u>2825</u>			
Bl. <u>Reef</u>	<u>3094</u>			
L.				Geol.
K.C. <u>Blaine</u>	<u>1575</u>	<u>1562</u>		
B.K.C. <u>B. Blaine</u>	<u>1658</u>			Contr.
Ce. <u>Anty</u>	<u>2344-00</u>			
E. <u>Welling</u>	<u>2545</u>	<u>2538</u>		
M. <u>Herr</u>	<u>2845</u>	<u>2840</u>		
M. <u>Reef</u>	<u>3104</u>	<u>3102</u>		Pool
K. <u>W.R.B.</u>	<u>3531</u>	<u>3525</u>		<u>Wildcat</u>
Mz. <u>TP</u>	<u>3733</u>	<u>3730</u>		
Mo. <u>H6</u>	<u>3927</u>	<u>3925</u>		
V. <u>LS9</u>	<u>3995</u>	<u>4001</u>		
S. <u>Marm</u>	<u>4425</u>	<u>4423</u>		
S. <u>Mur</u>		<u>4764</u>		
A. <u>Miss</u>		<u>4939</u>		
R.				
PE.				
G.				
TD.	<u>5040</u>			

ABANDONED

OCT 3 '56

0

Date Comm.

Vicker & PEPL - DHM

Location SEP-19 '56 9-8-56 1.3"

@ 359/300 DST 2797-11 or

1hr 70' GCM BHP Failed

SEP 26 '56

DST 2757-87 acc. 1hr

acc 70' GCM BHP Failed

4747 OCT 3 '56

DEA