


Section 7 Township 27 Range 9E

Well No. #1 ~~#2~~ Stewart - "B"

Company K. T. Weedemann

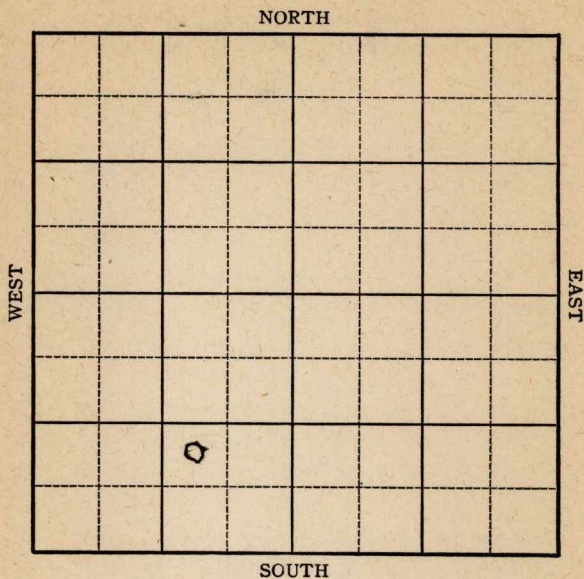

Sec. 7 Twp. 27 R. 9E

Well No. #1 #2, Stewart "B" Farm

K.T. Weedeman Company


Miscellaneous

Ft. from N. Line

990 Ft. from S. Line

990 Ft. from E. Line

Ft. from W. Line

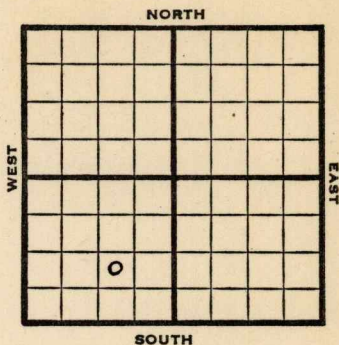

NW SE SW

REPORT

1946

6/12	RUR		
6/18	Spud		
6/26	10" @ 20		
	Drlg 1360'		
7/3	Miss 2402-15 TD SO		
	5" @ 2402 RUST		
7/9	"	"	"
7/16	"	"	"
7/23	"	"	"
7/30	"	"	"
8/6	"	"	"
8/13	"	"	"
8/20	"	"	"
8/22	"	"	"
9/5	"	"	"
9/10	"	"	"
9/18	"	"	"
9/25	Miss 2404'		
	5" @ 2402'		
	TD 2418'		
	650,000 Gas		

COMPLETED

KANSASKansas Pool Name MiscellaneousMap No. 10 Sec. 7 Twp. 27 R. 9EWell No. 2 StewartK. T. Weedemann

Company

FIRST REPORT

Contractor

NW SE SW

SECTION PLAT

 Ft. from N. Line990 Ft. from S. Line990 Ft. from E. Line Ft. from W. LineGreenwood CountyLocation Rig up

Drilling and Remarks:

RUR

RECORDCased in., ft.Sand Gas Oil Total Depth **PRODUCTION**1st 24 hrs. Nat. 1st 24 hrs. after shot Gas Cu. Ft.Dry Hole Abandoned

Date

JUN 12 194619S. J. LEWIS

Scout

Kansas Pool Name Miscellaneous

KANSAS
 Map No. 10 Sec. 7 Twp. 27 R. 9E

Well No. 1 Stewart "B"

K. T. Weidemann Company

CORRECTION Contractor

NW SE SW

SECTION PLAT

	0		

 Ft. from N. Line990 Ft. from S. Line990 Ft. from E. Line Ft. from W. LineGreenwood CountyLocation Rig up

Drilling and Remarks:

Reported

#2 Stewart

RECORDCased in., ft.Sand Gas Oil Total Depth **PRODUCTION**1st 24 hrs. Nat. 1st 24 hrs. after shot Gas Cu. Ft.Dry Hole Abandoned

Date

JUN 19 1946

19

S. J. LEWIS

Scout

KANSAS

Kansas Pool Name MiscellaneousMap No. 10 Sec. 7 Twp. 27 R. 9EWell No. 1 Stewart "B"K. T. Weidemann

Company

COMPLETED

Contractor

NW SE SW

SECTION PLAT

	0		

 Ft. from N. Line990 Ft. from S. Line990 Ft. from E. Line Ft. from W. LineGreenwood CountyLocation Rig up

Drilling and Remarks:

*Miss 2402**5" C2402**650,000 Gas*

RECORD

Cased in., ft.Sand Gas Oil Total Depth 2450

PRODUCTION

1st 24 hrs. Nat. 1st 24 hrs. after shot Gas

Cu. Ft.

Dry Hole Abandoned

Date

SEP 25 1946

19

S. J. LEWIS

Scout