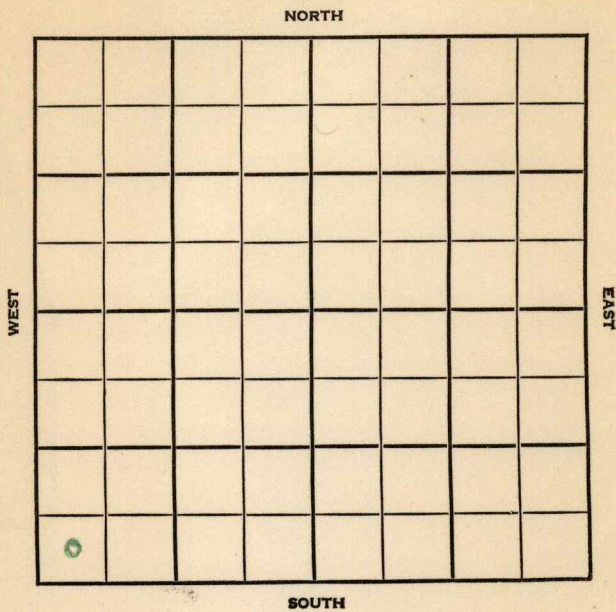


Section 9 Township 27 Range 9 EWell No. #1 Gould Est.Company Beaumont Pet.

Greenwood

KANSAS

SEC.	TWP.	R.
9	27	9E

WELL NO.

#1 Gould Est.

FARM

COMPANY

Beaumont Pet.

CONTRACTOR

Co. Tools

WILDCAT


Ft. from N. Line

Ft. from S. Line

Ft. from E. Line

Ft. from W. Line

SW SW SW

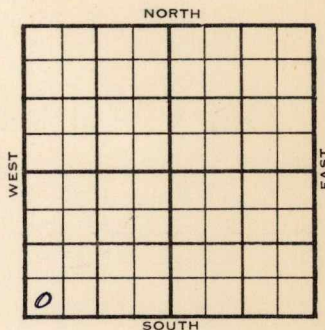

	ELEVATION	REPORT
1956	1290 KB	
2-22	MIR	
3-21	Comm. 2-20-56 8 5/8" @ 64 5 1/2" @ 2737 DD 2788 HFW D & A KC 1575 BKC 1751 Marm 1889 Ce. sh. 2060 Cherty lm 2373 K. 2683 A. 2732 TD 2737	

ABANDONED

County Greenwood Elev. _____
 Sec. 9 Twp. 27 Rge. 9E
 Company Beaumont Pet.
 Farm Name Gould Est. No. 1

TOPS	DEPTH	LOG	DATUM	Loc. in Sec.
Anh.				SW SW SW
Tp.				
H.				
Tr.				
Dg.				
BL.				
L.				Geol.
K.C.				Contr.
B.K.C.				Co. tools
Ce.				Pool
C.				Wildcat
M.				
M.				
K.				
Mz.				
Mq.				
V.				
S.				
S.				
A.				
R.				
Pe.				
G.				
T.D.				

Date Comm.

M I R

FIRST REPORT
 FEB 22 '56

Co.

Lse.

No.

Sec.

T.

R.

County Greenwood Elev. 1290 KB
 Sec. 9 Twp. 27 Rge. 9E
 Company Beaumont Pet.
 Farm Name Gould Est. No. 1

TOPS	DEPTH	LOG	DATUM	Loc. in Sec.
Anh.				SW SW SW
Tp.				
H.				
Tr.				
Dg.				
Bl.				
L.				
K.C.	1575		285	Geol.
B.K.C.	1751		461	Contr.
Ce. <u>Mary</u>	1889		599	Co. tools
C. <u>Se. sh.</u>	2060		770	
M. <u>Cherty lm.</u>	2373		1083	
M.				Pool
K.	2683		1393	Wildcat
Mz.				
Mq.				
V.				
S.				
S.				
A.	2732		1442	
R.				
Pf.				
G.				
T.D.	2737			

Date Comm. 2-20-56 MAR 21 1956
8 5/8" @ 64 5 1/2" @ 2737 DD 2788 HFW

D & A