

KANSAS

Russell


Sec. 25 Twp. 13 R. 15-W

Well No. #1 Cook "B" Farm

Jones & Shelborne

Company

NORTH

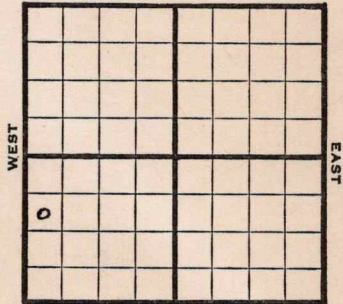

990 Ft. from N. Line

Ft. from S. Line

Ft. from E. Line

330 Ft. from W. Line

SOUTH

SW NW SW

1947 Elev. 1887' REPORT

4/9 Location

4/15 RUR

4/23 8" @ 946'
Anhy 930
Drlg 950'

4/29 Lansing 3853'
Arbuckle 3302'-09' TD
Run 5"

5/7 5" @ 3303
TD 3322'
Plug 3260
25 shots 3207-11
500 Acid CO

5/14 Arb. 3302'
5" @ 3303'
TD 3322'

ABANDONED

KANSAS

Dillner Pool

Form 26 200 Bks. 10-46 Petrol
Kansas

Map No. K 72 Sec. 25 Twp. 13 R. 15W

Well No. 1 Cook "B"

Jones & Shelborne Company

FIRST REPORT Contractor

SW NW SW


SECTION PLAT

990 Ft. from N. Line

 Ft. from S. Line

 Ft. from E. Line

330 Ft. from W. Line

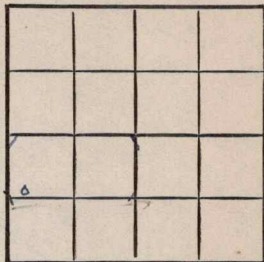

Russell County

Location X

Rig up

Drilling and Remarks:

RECORD

Cased in., ft.

Sand

Gas

Oil

Total Depth

PRODUCTION

1st 24 hrs. Nat.

1st 24 hrs. after shot

Gas Cu. Ft.

Dry Hole

Abandoned

Date

APR 9 1947 19

S. J. LEWIS Scout

Map No. 1572 Sec. 25 Twp. 13 R. 15W

Well No. 1 Cook "B"

Jones & Shelborne Company

ABANDONED Contractor

SW NW SW

E. 1887
SECTION PLAT

990 Ft. from N. Line

_____ Ft. from S. Line

_____ Ft. from E. Line

330 Ft. from W. Line

Russell County

Location _____

Rig up _____

Drilling and Remarks:

Cur 3302
5" @ 3303

RECORD

Cased _____ in., _____ ft.

Sand _____

Gas _____

Oil _____

Total Depth 3322

PRODUCTION

1st 24 hrs. Nat. _____

1st 24 hrs. after shot _____

Gas _____ Cu. Ft.

Dry Hole _____

Abandoned _____

Date

MAY 14 1947 19 _____

S. J. LEWIS Scout