

Sec. 19 Twp. 27 Range 8E

#1 Shriver

Kansas Geological Society

Root & Neff

Skelly Scout Tickets

Map No. _____ Sec. 19 Twp. 27 R. 8


Well No. 1 Shriver Farm

Root & Neff Company

NORTH

WEST

EAST

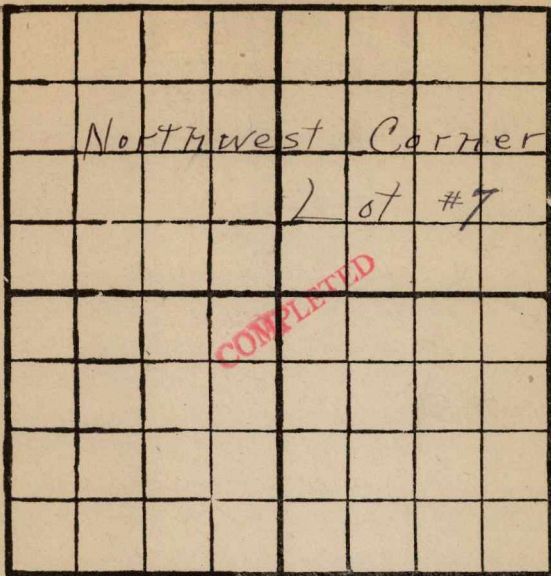

SOUTH

Map No. _____ Sec. _____ Twp. _____ R. _____

Well No. _____

_____ Company

_____ Contractor

WEST		NORTH Tracing _____ J. S. C. map _____ Frantz map _____ Moody map _____ Frantz plat book _____ Moody plat book _____								EAST	
		SOUTH									

	RECORD
Location _____	Cased _____ in., _____ ft.
Rig up _____	Sand _____
Drilling and Remarks:	Gas _____
	Oil _____
	Total Depth _____
	PRODUCTION
	1st 24 hrs. Nat. _____
	1st 24 hrs. after shot _____
	Gas _____ Cu. Ft.
	Dry Hole _____
	Abandoned _____

Date _____

Map No. _____ Sec. _____ Twp. _____ R. _____

Well No. _____

Company _____

Contractor _____

Note:--

This is about
2 miles east of the
Baruchill well

23-27-7 which

The Casden Oil

Co had a

hole in

Location _____

Rig up _____

Drilling and Remarks: _____

Oil _____

Total Depth _____

PRODUCTION

1st 24 hrs. Nat. _____

1st 24 hrs. after shot _____

Gas _____

Dy. Hole _____

Abandoned _____

Date _____

191 _____

Map No. 1510 Sec. 19 Twp. 27 R. 8

Well No. 1 Shiner


Root & Key Company

Contractor

NORTH

WEST

EAST

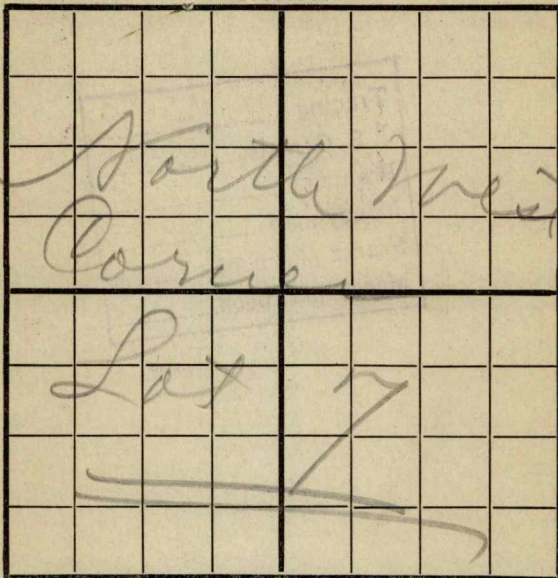

SOUTH

RECORD

Location ✓

Cased _____ in., _____ ft.

Rig up ✓

Sand _____

Drilling and Remarks:

Gas _____

Oil _____

Total Depth _____

PRODUCTION

FIRST REPORT

1st 24 hrs. Nat. _____

1st 24 hrs. after shot _____

Gas _____ Cu. Ft.

Dry Hole _____

Abandoned _____

Date

10/28/8 Candy Scout


Map No. K10 Sec. 19 Twp. 27 R. 8Well No. 1 ShriverRoot & Jeff Company

Contractor

NORTH

WEST

EAST

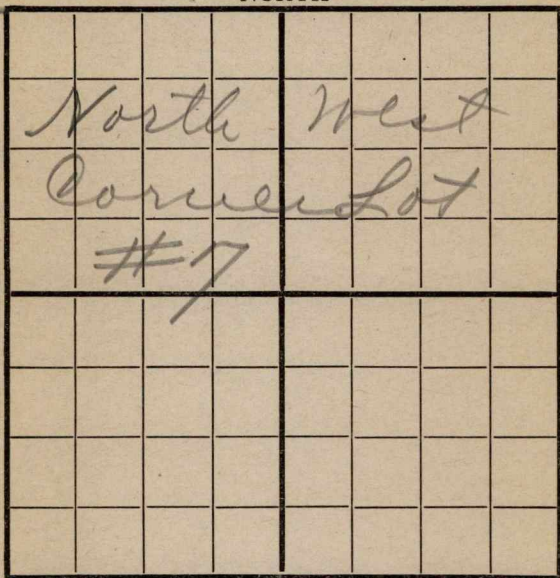

SOUTH

Location _____

Rig up ☒ _____

Drilling and Remarks:

RECORD

Cased _____ in., _____ ft.

Sand _____

Gas _____

Oil _____

Total Depth _____

PRODUCTION

1st 24 hrs. Nat. _____

1st 24 hrs. after shot _____

Gas _____ Cu. Ft.

Dry Hole _____

Abandoned _____

Date

10/30 1918 Candyp Scout


Map No. K10 Sec. 19 Twp. 27 R. 8Well No. 1 ShriverRoot & Neff Company

Contractor

NORTH

WEST

EAST

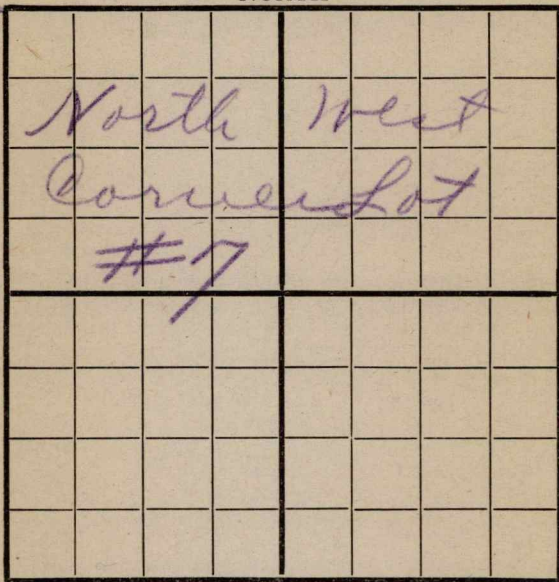

SOUTH

RECORD

Location _____

Cased _____ in., _____ ft.

Rig up ☒

Sand _____

Drilling and Remarks:

Gas _____

Oil _____

Total Depth _____

PRODUCTION

1st 24 hrs. Nat. _____

1st 24 hrs. after shot _____

Gas _____ Cu. Ft.

Dry Hole _____

Abandoned _____

Date

11/6191S. Conroy

Scout


Map No. K10 Sec. 19 Twp. 27 R. 8Well No. 1 SkinnerPort & Huff Company

Contractor

NORTH

WEST

EAST

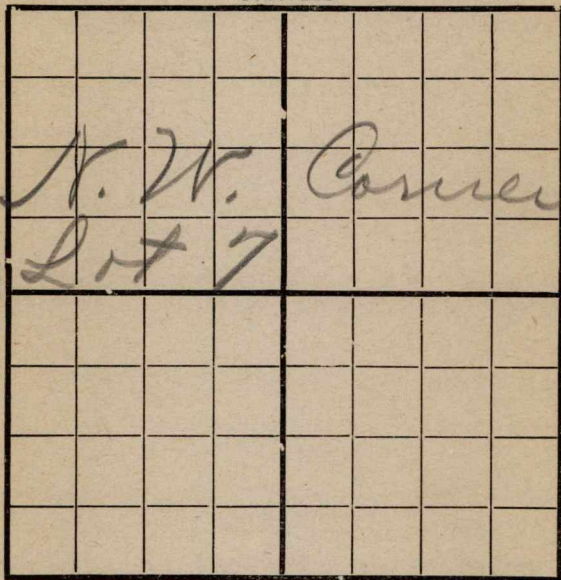

SOUTH

Location _____

Rig up _____

Drilling and Remarks:

Rigging
up

RECORD

Cased _____ in., _____ ft.

Sand _____

Gas _____

Oil _____

Total Depth _____

PRODUCTION

1st 24 hrs. Nat. _____

1st 24 hrs. after shot _____

Gas _____ Cu. Ft.

Dry Hole _____

Abandoned _____

Date


11/13 1918 S. Canfield Scout

Map No. K 10 Sec. 19 Twp. 27 R. 8Well No. 1 Shriver
Root & Keff Company
Contractor

NORTH

WEST

EAST

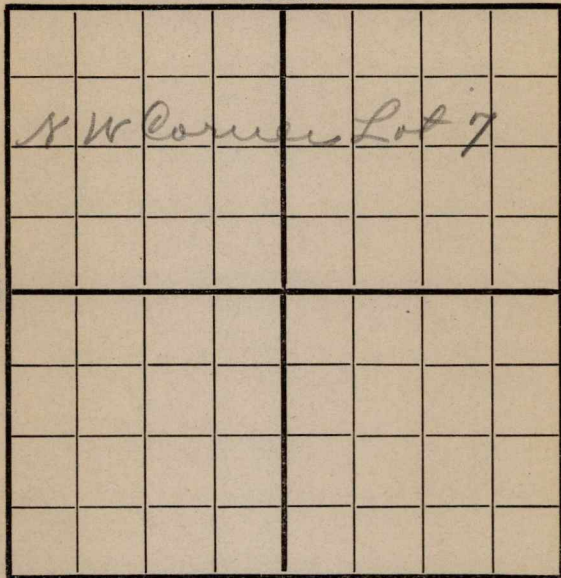

SOUTH

Location _____

Rig up _____

Drilling and Remarks:

200

RECORD

Cased _____ in., _____ ft.

Sand _____

Gas _____

Oil _____

Total Depth _____

PRODUCTION

1st 24 hrs. Nat. _____

1st 24 hrs. after shot _____

Gas _____ Cu. Ft.

Dry Hole _____


Abandoned _____

Date

11/20191S. Condy

Scout

Map No. K10 Sec. 19 Twp. 27 R. 8
Well No. 1 Shriver
Root & Kepp Company
Contractor

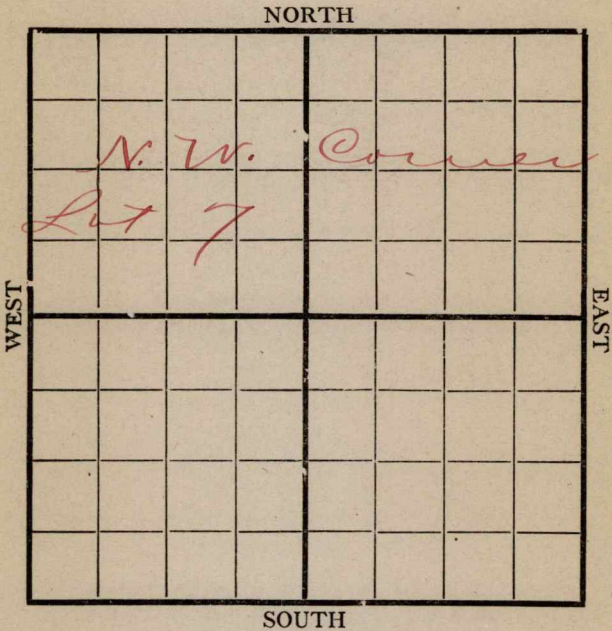

Location _____

Rig up _____

Drilling and Remarks:

No Report -
Last depth
290
Spudding 290.
will spud to 300 before
hooking on to beam

Date

RECORD

Cased _____ in., _____ ft.

Sand _____

Gas _____

Oil _____

Total Depth _____

PRODUCTION

1st 24 hrs. Nat. _____

1st 24 hrs. after shot _____

Gas _____ Cu. Ft.

Dry Hole _____

Abandoned _____

11/27 1918 Conley Scout


Map No. K10 Sec. 19 Twp. 27 R. 8Well No. 1 ShumanRoot & Jeff Company

Contractor

NORTH

WEST

EAST

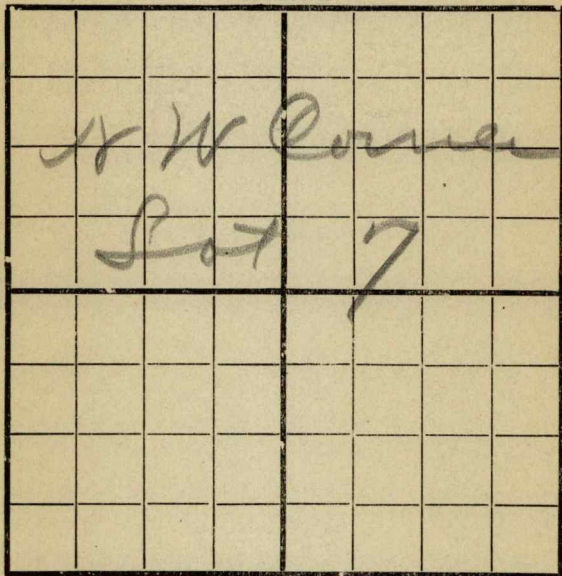

SOUTH

Location _____

Rig up _____

Drilling and Remarks:

425

RECORD

Cased _____ in., _____ ft.

Sand _____

Gas _____

Oil _____

Total Depth _____

PRODUCTION

1st 24 hrs. Nat. _____

1st 24 hrs. after shot _____

Gas _____ Cu. Ft.

Dry Hole _____

Abandoned _____

Date


12/4 1918 Conley Scout

Map No. K10 Sec. 19 Twp. 27 R. 8Well No. 1 ShinerRoot & Jeff Company

Contractor

NORTH

WEST

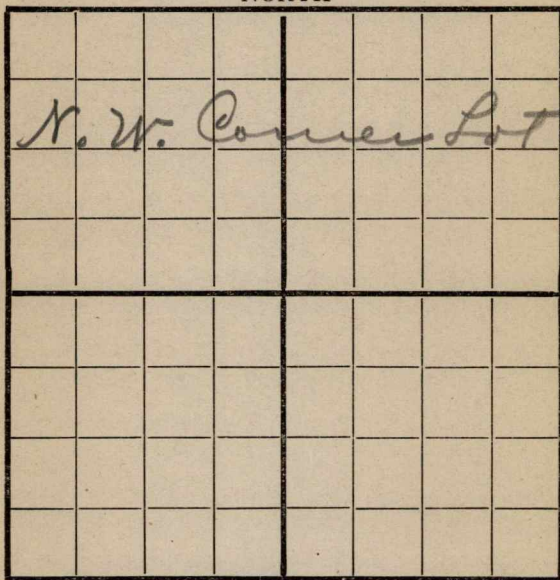

EAST

SOUTH

Location _____

Rig up _____

Drilling and Remarks:

Set 12 1/2 at 900Drilling 1050

RECORD

Cased _____ in., _____ ft.

Sand _____

Gas _____

Oil _____

Total Depth _____

PRODUCTION

1st 24 hrs. Nat. _____

1st 24 hrs. after shot _____

Gas _____ Cu. Ft.

Dry Hole _____

Abandoned _____

Date

12/14

191

8 C. Jeff


Scout

Map No. K10 Sec. 19 Twp. 27 R. 8Well No. 1 ShriverRoot & Keff Company

Contractor

NORTH

WEST

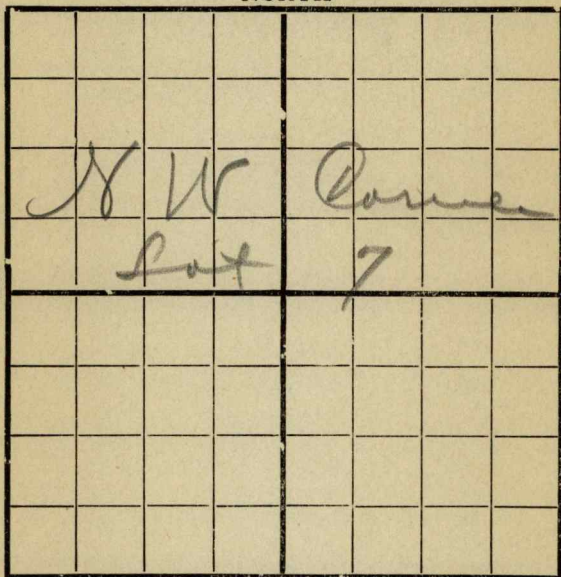

EAST

SOUTH

Location _____

Rig up _____

Drilling and Remarks:

1125

RECORD

Cased _____ in., _____ ft.

Sand _____

Gas _____

Oil _____

Total Depth _____

PRODUCTION

1st 24 hrs. Nat. _____

1st 24 hrs. after shot _____

Gas _____ Cu. Ft.

Dry Hole _____

Abandoned _____

Date

12/18

191

8 Conley


Scout

Map No. 510 Sec. 19 Twp. 27 R. 8Well No. ShrineRoutledge Company

Contractor

NORTH

WEST

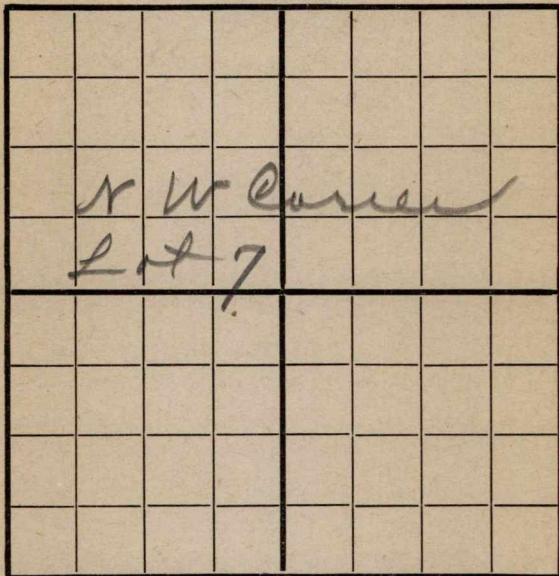

EAST

SOUTH

Location _____

Rig up _____

Drilling and Remarks:

Hole full
water 1480

RECORD

Cased _____ in., _____ ft.

Sand _____

Gas _____

Oil _____

Total Depth _____

PRODUCTION

1st 24 hrs. Nat. _____

1st 24 hrs. after shot _____

Gas _____ Cu. Ft.

Dry Hole _____

Abandoned _____

Date

12/25/1918 C. C. Cuddy Scout


Map No. 1510 Sec. 19 Twp. 27 R. 8Well No. Shirley

Company _____

Contractor _____

NORTH

WEST

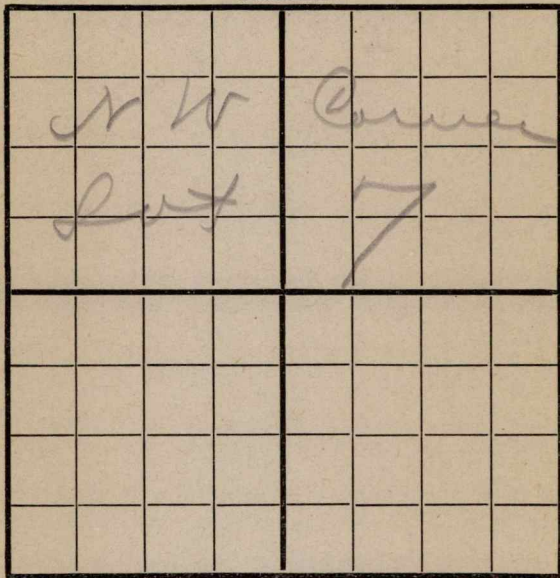

SOUTH

Location _____

Rig up _____

Drilling and Remarks:

AD 1480

RECORD

Cased _____ in., _____ ft.

Sand _____

Gas _____

Oil _____

Total Depth _____

PRODUCTION

1st 24 hrs. Nat. _____

1st 24 hrs. after shot _____

Gas _____ Cu. Ft.

Dry Hole _____

Abandoned _____

Date

1/1 1919 9 Conley Scout


Map No. 1510 Sec. 19 Twp. 27 R. 8Well No. ShriverRoot & Jeff Company

Contractor

NORTH

WEST

EAST

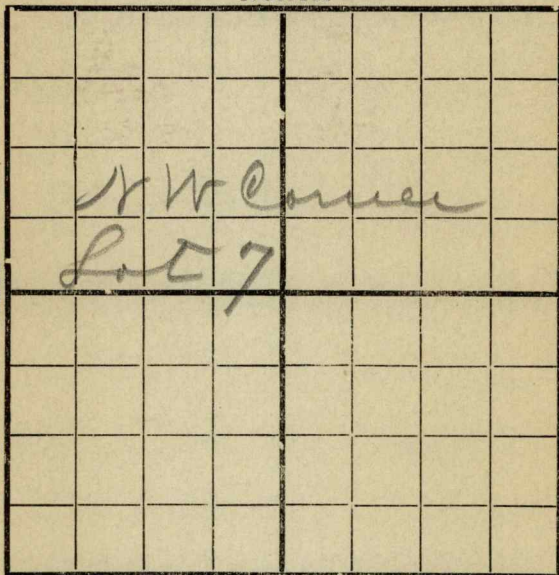

SOUTH

Location _____

Rig up _____

Drilling and Remarks:

22
1480

RECORD

Cased _____ in., _____ ft.

Sand _____

Gas _____

Oil _____

Total Depth _____

PRODUCTION

1st 24 hrs. Nat. _____

1st 24 hrs. after shot _____

Gas _____ Cu. Ft.

Dry Hole _____

Abandoned _____

Date

1/8 1919 C. Conroy Scout


Map No. 1510 Sec. 19 Twp. 27 R. 8Well No. ShinerRoot & Meff Company

Contractor

NORTH

WEST

EAST

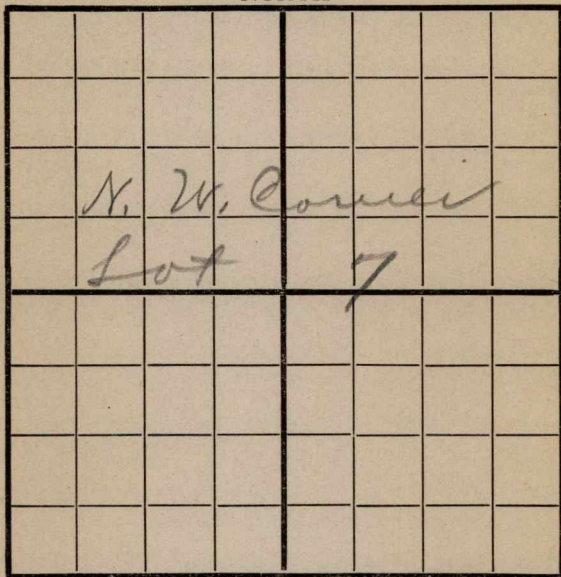

SOUTH

Location _____

Rig up _____

Drilling and Remarks:

2 2 14 80

RECORD

Cased _____ in., _____ ft.

Sand _____

Gas _____

Oil _____

Total Depth _____

PRODUCTION

1st 24 hrs. Nat. _____

1st 24 hrs. after shot _____

Gas _____ Cu. Ft.

Dry Hole _____

Abandoned _____


Date

1/15 1919 9 Conley Scout

Map No. 1510 Sec. 19 Twp. 27 R. 8Well No. 1 ShriverRoot & Keff Company

Contractor

NORTH

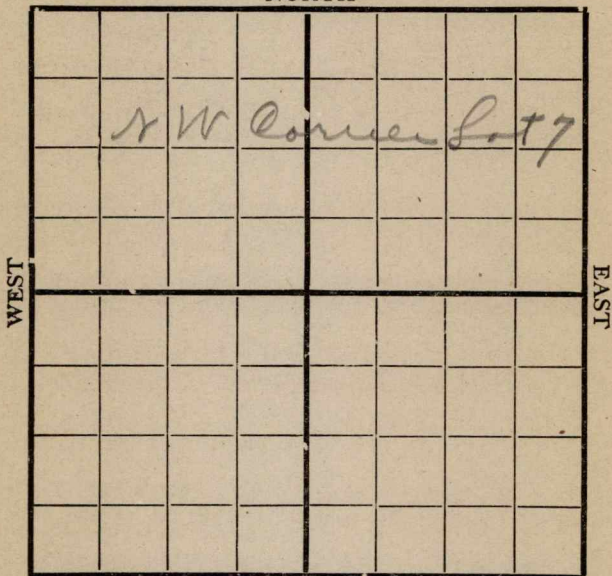

SOUTH

Location _____

Rig up _____

Drilling and Remarks:

1600

RECORD

Cased _____ in., _____ ft.

Sand _____

Gas _____

Oil _____

Total Depth _____

PRODUCTION

1st 24 hrs. Nat. _____

1st 24 hrs. after shot _____

Gas _____ Cu. Ft.

Dry Hole _____

Abandoned _____

Date

1/22 1919 Conley Scout

Map No. 510 Sec. 19 Twp. 27 R. 8
 Well No. 1 Shriver
Root & Meff. Company _____ Contractor _____

NORTH

WEST	0								EAST

NW Cor Lot #7 SOUTH

Location _____

Rig up _____

Drilling and Remarks:

M.R. 10" to 1650

RECORD

Cased _____ in., _____ ft.

Sand _____

Gas _____

Oil _____

Total Depth _____

PRODUCTION

1st 24 hrs. Nat. _____

1st 24 hrs. after shot _____

Gas _____ Cu. Ft.

Dry Hole _____

Abandoned _____

Date

Jan 29 1919

Pyle

Scout

Map No. K10 Sec. 19 Twp. 27 R. 8


Well No. 1 Shriver
Root & Neff- Company

Contractor

NORTH

WEST

EAST

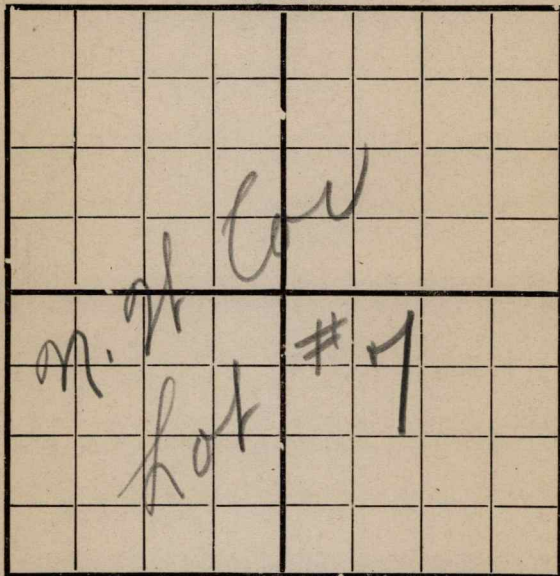

SOUTH

Location _____

Rig up _____

Drilling and Remarks:

21 R10" to
1650

RECORD

Cased _____ in., _____ ft.

Sand _____

Gas _____

Oil _____

Total Depth _____

PRODUCTION

1st 24 hrs. Nat. _____

1st 24 hrs. after shot _____

Gas _____ Cu. Ft.

Dry Hole _____

Abandoned _____

Date


2/6 1919

Pyle

Scout

Map No. K10 Sec. 19 Twp. 27 R. 8Well No. 1 ShriverRoot & Jeff- Company

Contractor

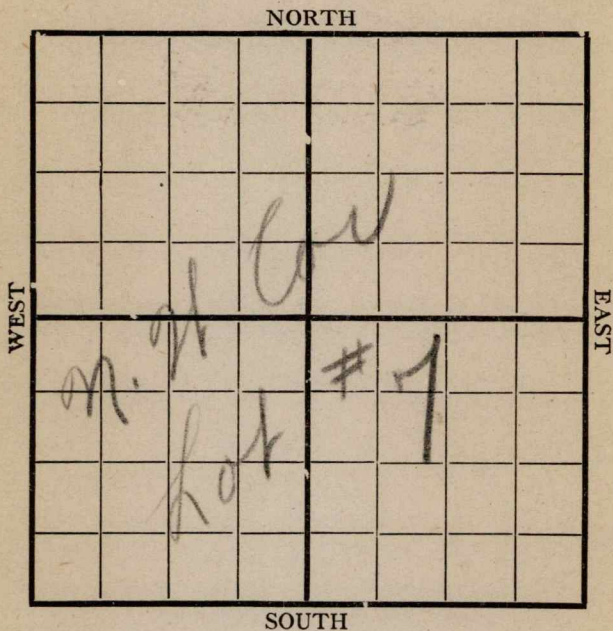

Location _____

Rig up _____

Drilling and Remarks:

2100'

RECORD

Cased _____ in., _____ ft.

Sand _____

Gas _____

Oil _____

Total Depth _____

PRODUCTION

1st 24 hrs. Nat. _____

1st 24 hrs. after shot _____

Gas _____ Cu. Ft.

Dry Hole _____

Abandoned _____

Date

7/12

1919

Oyle

Scout


Map No. K10 Sec. 19 Twp. 27 ^S R. 8 ^EWell No. 1 ShriverPool & Neff

Company

Contractor

NORTH

WEST

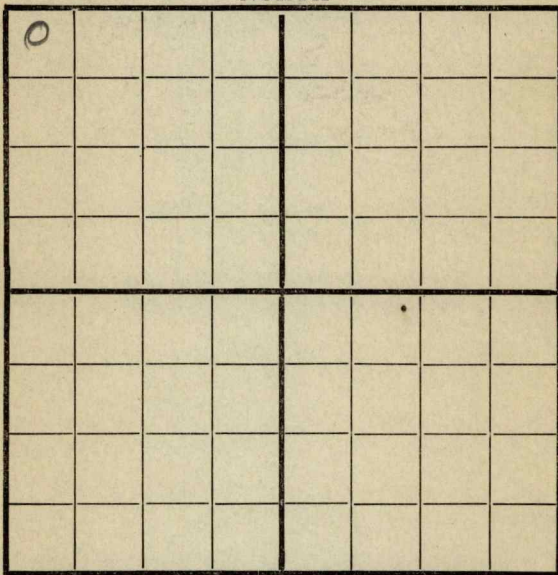

EAST

N-W Cor of lot #7

SOUTH

RECORD

Location _____

Cased _____ in., _____ ft.

Rig up _____

Sand _____

Drilling and Remarks:

Gas _____

Oil _____

Total Depth _____

2260'

PRODUCTION

1st 24 hrs. Nat. _____

1st 24 hrs. after shot _____

Gas _____ Cu. Ft.

Dry Hole _____

Abandoned _____

Date

2/21

1919

Pyle

Scout

Map No. K10 Sec. 19 Twp. 27 S. 8 E.

Well No. 1 Shriver


Root & Neff Company

Contractor

NORTH

WEST

EAST

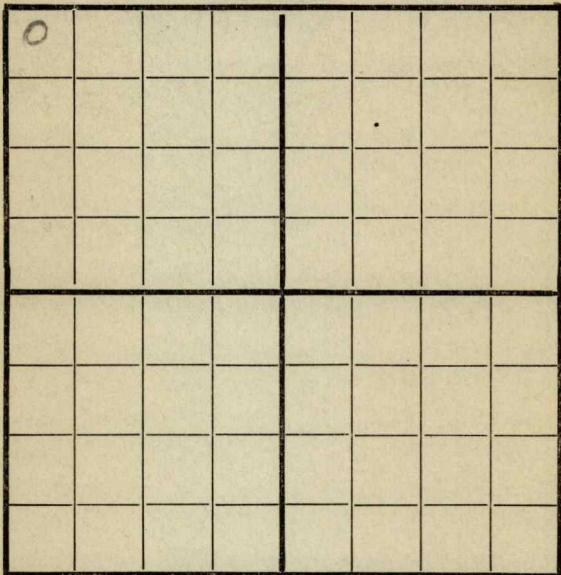

SOUTH

N-W corner of lot #7

Location _____

Rig up _____

Drilling and Remarks:

RECORD

Cased _____ in., _____ ft.

Sand _____

Gas _____

Oil _____

Total Depth _____

PRODUCTION

1st 24 hrs. Nat. _____

1st 24 hrs. after shot _____

Gas _____ Cu. Ft.


Dry Hole _____

Abandoned _____

Date

2/25 1919 Pyle Scout

Map No. K10 Sec. 19 Twp. 27^S R. 8^E
 Well No. 1 Shriver
Root & Neff- Company _____ Contractor _____

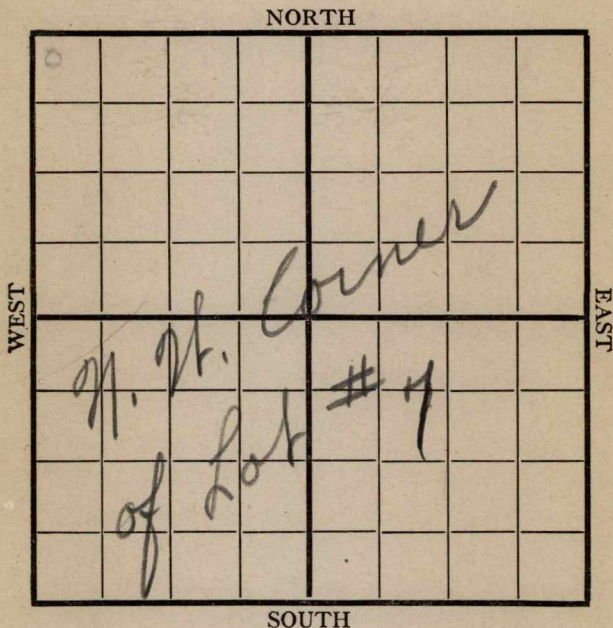

Location _____

Rig up _____

Drilling and Remarks:

*D. D. for
orders @
2600*

RECORD

Cased _____ in., _____ ft.

Sand _____

Gas _____

Oil _____

Total Depth _____

PRODUCTION

1st 24 hrs. Nat. _____

1st 24 hrs. after shot _____

Gas _____ Cu. Ft.

Dry Hole _____

Abandoned _____

Date


3/5

191*9*

Pyle

Scout

Map No. K10 Sec. 19 Twp. 27 R. 8 E
 Well No. 1 Shriver
Root & Neff- Company _____ Contractor _____

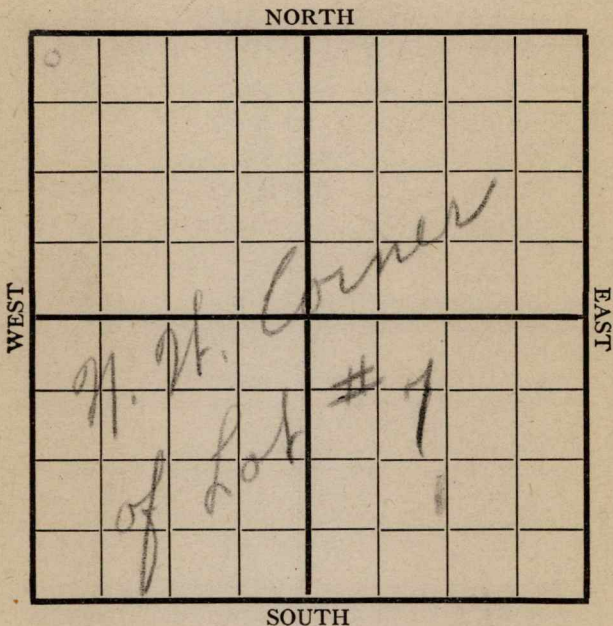


	RECORD
Location _____	Cased _____ in., _____ ft.
Rig up _____	Sand _____
Drilling and Remarks:	Gas _____
	Oil _____
	Total Depth _____
	PRODUCTION
	1st 24 hrs. Nat. _____
	1st 24 hrs. after shot _____
	Gas _____ Cu. Ft.
	Dry Hole _____
	Abandoned _____

D. D. @
2600
completed contract

Date 3/13 1919 Cyph Scout

Map No. K10 Sec. 19 Twp. 27 R. 8Well No. ShrinerRoot & Co. Company

Contractor

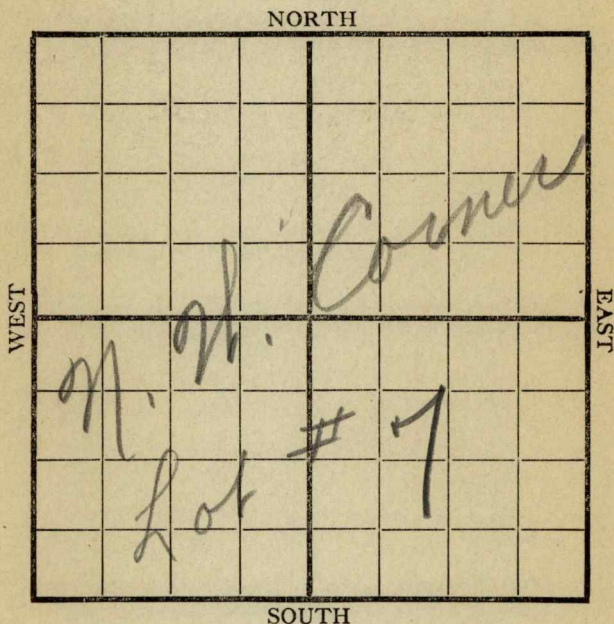

Location _____

Rig up _____

Drilling and Remarks:

*D. D. @
2600'*

RECORD

Cased _____ in., _____ ft.

Sand _____

Gas _____

Oil _____

Total Depth _____

PRODUCTION

1st 24 hrs. Nat. _____

1st 24 hrs. after shot _____

Gas _____ Cu. Ft.

Dry Hole _____

Abandoned _____


Date

3/18 191*9*

Pyle

Scout


Map No. K10 Sec. 19 Twp. 27 R. 8
 Well No. 1 Shriver
Root & Meff- Company
 Contractor

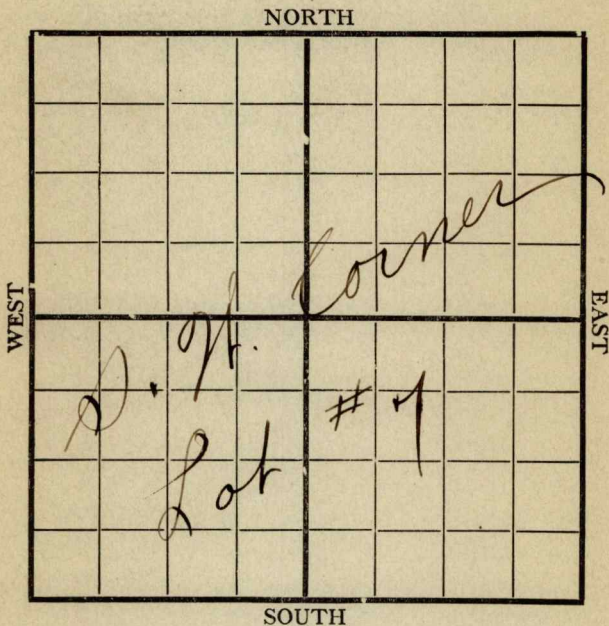

	RECORD
Location _____ Rig up _____ Drilling and Remarks: <u>1</u> Olg 2720	Cased _____ in., _____ ft. Sand _____ Gas _____ Oil _____ Total Depth _____ PRODUCTION 1st 24 hrs. Nat. _____ 1st 24 hrs. after shot _____ Gas _____ Cu. Ft. Dry Hole _____ Abandoned _____

Date 3/27 1919 Pyle Scout

Map No. K10 Sec. 19 Twp. 27 R. 8
 Well No. 1 Shriver
Root & Neff Company
 Contractor

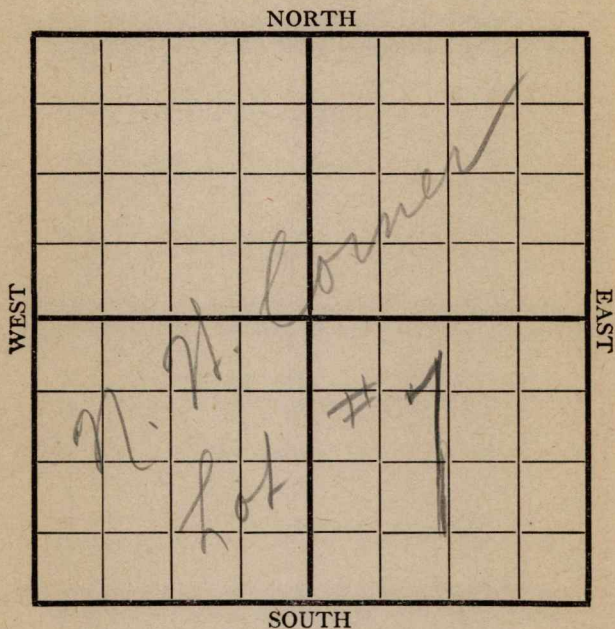

Location _____

Rig up _____

Drilling and Remarks:

RECORD

Cased _____ in., _____ ft.

Sand _____

Gas _____

Oil _____

Total Depth _____

PRODUCTION

1st 24 hrs. Nat. _____

1st 24 hrs. after shot _____

Gas _____ Cu. Ft.

Dry Hole _____

Abandoned _____

Date

4/5

1919

Pyle

Scout


Map No. *K 10* Sec. *19* Twp. *27* R. *8*Well No. *1 Shriver**Root & Co.* Company

Contractor

NORTH

WEST

EAST

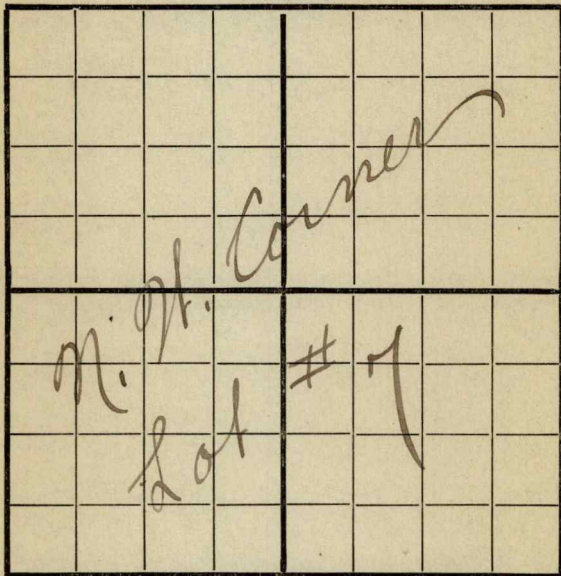

SOUTH

Location _____

Rig up _____

Drilling and Remarks:

fishing bit
@
2740'

RECORD

Cased _____ in., _____ ft.

Sand _____

Gas _____

Oil _____

Total Depth _____

PRODUCTION

1st 24 hrs. Nat. _____

1st 24 hrs. after shot _____

Gas _____ Cu. Ft.

Dry Hole _____

Abandoned _____

Date


4/8 191 *9*

Pyle

Scout

Map No. K10 Sec. 19 Twp. 27 R. 8Well No. 1 ShriverRoot & Neff. Company

Contractor

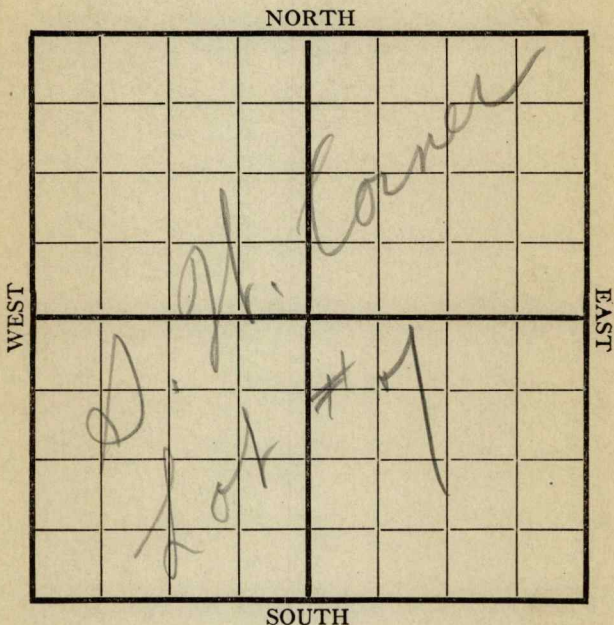

Location _____

Rig up _____

Drilling and Remarks:

*fishing
bit @
2740'*

RECORD

Cased _____ in., _____ ft.

Sand _____

Gas _____

Oil _____

Total Depth _____

PRODUCTION

1st 24 hrs. Nat. _____

1st 24 hrs. after shot _____

Gas _____ Cu. Ft.

Dry Hole _____

Abandoned _____

Date

4/18 1919

Pyle

Scout

Map No. K10 Sec. 19 Twp. 27 R. 8Well No. 1 Shiner
Pool & Neff. Company _____

Contractor _____

NORTH

WEST

EAST

SOUTH

Location _____

Rig up _____

Drilling and Remarks:

RECORD

Cased _____ in., _____ ft.

Sand _____

Gas _____

Oil _____

Total Depth _____

PRODUCTION

1st 24 hrs. Nat. _____

1st 24 hrs. after shot _____

Gas _____ Cu. Ft.

Dry Hole _____

Abandoned _____

Date

4/23 1919

Pyle

Scout

Map No. 1510 Sec. 19 Twp. 27 R. 8

Well No. 1 Shively


Root & Neff Company

Contractor

NORTH

WEST

EAST

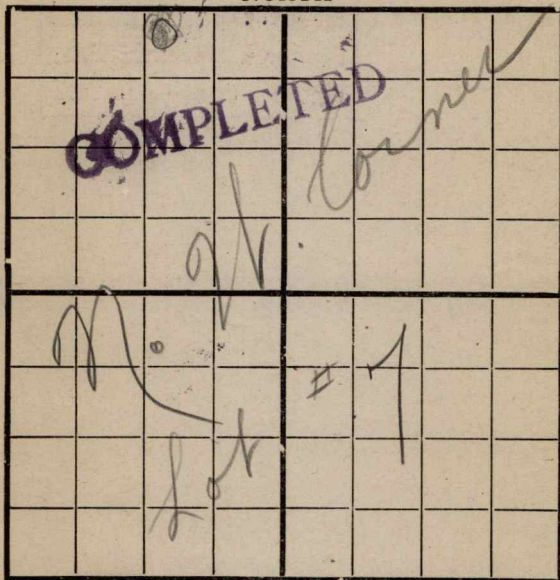

SOUTH

Location _____

Rig up _____

Drilling and Remarks:

RECORD

Cased _____ in., _____ ft.

Sand _____

Gas _____

Oil _____

Total Depth _____

PRODUCTION

1st 24 hrs. Nat. _____

1st 24 hrs. after shot _____

Gas _____ Cu. Ft.

Dry Hole 2770

Abandoned _____

Date

5/7 1919 Pyle Scout