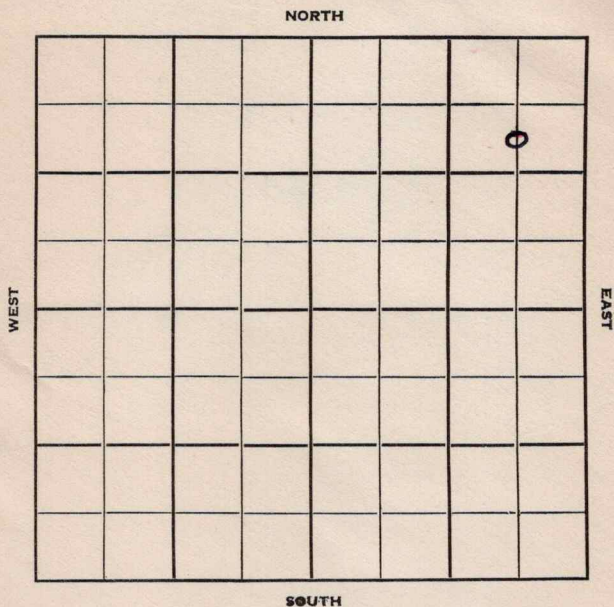


Section 25 Township 13 Range 15 WWell No. #1 StreckerCompany Bishop Oil

Russell

Sec. 25 Twp. 13 R. 15W

Well No. #1 Strecker Farm

Bishop Oil Company

Bishop - Contr. Contractor


990' Ft. from N. Line

 Ft. from S. Line

660' Ft. from E. Line

 Ft. from W. Line

C S L NE NE

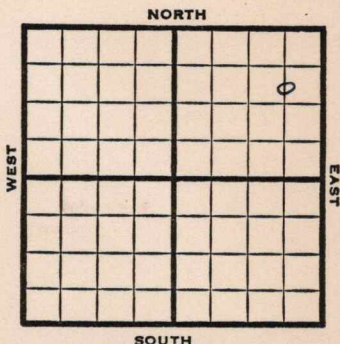

1951

Elev. 1876' REPORT

1/17

Spud 1-13-51
8" @ 287'
Drlg. 505'

2/14

Spud 1-13-51
D&A TD 3398'
8" @ 287' **Heeb. 2992'**
Lans. 3045'
DST 3080-90 opn $\frac{1}{2}$ hr Rec. 60' mud
Tarkio 2511' **Top. 2728'**
Arb. 3312' TD 3398'
5" @ 3396' 12/3321-25
S/5 bwph SP 3290
36/3081-93 40/3081-93
10 gwph SS0 1000 A
S/4 $\frac{1}{2}$ bw 1 $\frac{1}{2}$ boph 36/3081-93
S/4 $\frac{1}{2}$ bo 34 bw 12 hr.

ABANDONED

County Russell State Kansas

Sec. **25** (Blk. **13** (Sur. **15W** Map No.

Operator Bishop Oil

Well No. 1 Farm Strecker

Elev.	Location	C	S	L	N	E
60	100					
70	100					
FIRST REPORT

990 Ft. From N Line NE

660 Ft. From E Line Quarter

1st. Report JAN 17 1951

Completion

Remarks

Bishop - Contr.

Spudding Date 1-13-51

Orig. Data

8" @ 287 drlg. 505

County Russell State KansasSec. 25 (Blk.) 13 (Sur. Rge.) 15W Map No.Operator Bishop OilWell No. 1 Farm StreckerElev. 1876 Location C S L NE NE990 Ft. From N Line NE660 Ft. From E Line Quarter

1st. Report

Completion FEB 1 4 1951

Remarks

Bishop - Contr.Spudding Date 1-13-51Drlg. Data D & A TD 33988" @ 287 Heeb. 2992 Lans. 3045DST 3080-90 open $\frac{1}{2}$ hr. Rec. 60' mudTarkio 2511 Top. 2728 Arb. 3312TD 3398 5" @ 3396 12/ 3321-25 S/ 5 bwphSP 3290 36/ 3081-93 40/ 3081-9310 gwph SSO 1000 A S/ $4\frac{1}{2}$ bw $1\frac{1}{2}$ boph36/ 3081-93 S/ $4\frac{1}{2}$ bo 34 bw 12 hr.D & A

J. E. TYRA