


Map No. 1510 Sec. 23 Twp. 27 R. 8
 Well No. 1 Temper Farm
Uncle Sam Company

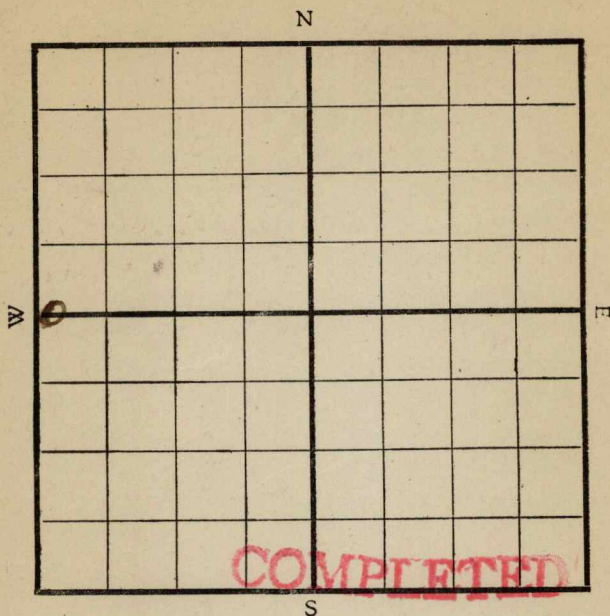

Location -----

Drilling Remarks:

Rig Up -----

Drilling Remarks:

RECORD

Cased ----- in. ----- ft.

Sand -----

Gas -----

Oil -----

Total Depth -----

PRODUCTION

1st 24 hrs. Nat. -----

1st 24 hrs. after shot -----

Gas ----- cu. ft.


Dry Hole -----

Abandoned -----

Map No. K10 Sec. 23 Twp. 27 R. 8Well No. 1 Turner FarmWheeler Sun oil Company2640 Ft. from N. Line

_____ Ft. from S. Line

_____ Ft. from E. Line

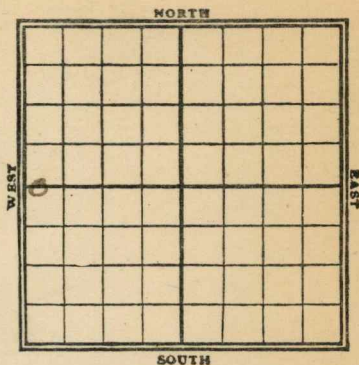200 Ft from W. Line

Date

REPORT

FIRST REPORT

4/2	Shed
24	✓ + SD
5/7	SD 460
20	—
6/13	Seg @ 980'
17	Seg @ 1600'
23	SL 1600
7/3	— 1650
10	— — —
22	— — —
28	— — 1700 - H.F.W.
8/6	SL @ 2200'
8/13	SL @ 2400'
8/21	SL @ 2400'
9/3	SLy @ 2540
9/14	— @ 2600'
22	SL @ 2600'
29	SLy 2800'
10/20	SLy hole 2927

Map No. K 10 Sec. 23 Twp. 27 R. 8Well No. 1 Temple
Uncle Sam Oil Company

Contractor _____

SECTION PLAT

2640 Ft. from N. Line

_____ Ft. from S. Line

_____ Ft. from E. Line

200 Ft. from W. Line

FIRST REPORT

RECORD

Location _____

Cased _____ in., _____ ft.

Rig up _____

Sand _____

Drilling and Remarks:

Gas _____

Oil _____

Total Depth _____

PRODUCTION

1st 24 hrs. Nat. _____

1st 24 hrs. after shot _____

Gas _____ Cu. Ft.

Dry Hole _____

Abandoned _____

Date

Pyle

191

Scout

Map No. K10 Sec. 23 Twp. 27 R. 8Well No. 1. TempleNucle Saw Oil Company

Contractor

SECTION PLAT

Ft. from N. Line

2640 Ft. from S. Line

Ft. from E. Line

200 Ft. from W. Line

COMPLETED

Location

Rig up

Drilling and Remarks:

RECORD

Cased _____ in., _____ ft.

Sand _____

Gas _____

Oil _____

Total Depth _____

PRODUCTION

1st 24 hrs. Nat. _____

1st 24 hrs. after shot _____

Gas _____ 'Cu. Ft.

Dry Hole 2927

Abandoned _____

Date

10/20 1920

Pyle

Scout