


Section 4 Township 32 Range 3-E

Well No. 3 Wilson


Company Earl Wakefield

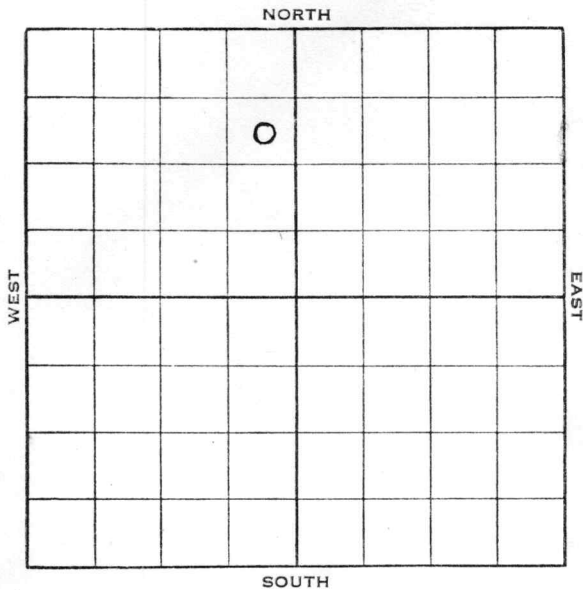

Sec. 4 Twp. 32 R. 3-E

Well No. #3 Wilson Farm
Earl Wakefield Company

990 Ft. from N. Line
 _____ Ft. from S. Line
330 Ft. from E. Line
 _____ Ft. from W. Line

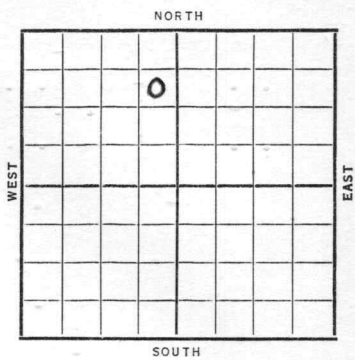

Elev. 1199

Date	REPORT
1938	
3/9	Location
3/18	"
3/25	"
4/1	"
4/8	"
4/15	"
4/22	"
4/29	C. R.
5/6	"
5/12	"
5/20	"
5/27	20" @ 87'. Drlg. 150'.
6/3	15" @ 558'. Drlg. 750'.
6/10	" "
6/17	12" @ 1296'. 10" at 1700'. Drlg. 1840'.
6/24	Drlg. 2148'.

OVER
2

1938

7/1 Stalnaker 2065-2164'

S.O. 2070-75 H.F.W. 2130'

8" - 2200' K.C. 2481

S.O. 2495' 4 B.W. 2515 T.D. 2575 U.R. 8"

7/8 8" - 2575'. Drlg. 3009'.

7/15 Miss. 3003'. S.O. 3065-70'.

6" - 3059'. T.D. 3150'.

800' oil. WOC.

7/20 6" - 3059'.

Miss. 3003'.

T. D. 3150'.

4000 acid.

Flowed 810 bbls. 4 hrs. & 521
bbls. 4 hrs.

Potential 3124 bbls.

Gravity 38.

COMPLETED

Cowley

KANSAS

Map No. 1 Sec. 4 Twp. 32 R. 3E

Well No. 3 Wilson

Earl Wakefield Company

Contractor

FIRST REPORT

SECTION PLAT

990 SE NE NW
Ft. from N. Line

_____ Ft. from S. Line

330 Ft. from E. Line

_____ Ft. from W. Line

	0		

Location X

Rig up _____

Drilling and Remarks:

RECORD

Cased _____ in., _____ ft.

Sand _____

Gas _____

Oil _____

Total Depth _____

PRODUCTION

1st 24 hrs. Nat. _____

1st 24 hrs. after shot _____

Gas _____ Cu. Ft.

Dry Hole _____

Abandoned _____

Date

MAR 9 - 1938

19

H. D. Hatfield

Scout

Cowley

Map No. 1 Sec. 4 Twp. 32 R. 3E

Well No. 3 Wilson

Earl Wakefield Company

Contractor

COMPLETED

SECTION PLAT

	0		

SE NE NW

990 Ft. from N. Line

_____ Ft. from S. Line

330 Ft. from E. Line

_____ Ft. from W. Line

Location _____

Rig up _____

Drilling and Remarks:

4000 Acid

Flowed 810/4 452/4

POT 3124

grav. 38

RECORD

Cased 6 in., 3059 ft.

Sand MISS 3003

Gas _____

Oil _____

Total Depth 3150

PRODUCTION

1st 24 hrs. Nat. _____

1st 24 hrs. after shot _____

Gas _____ Cu. Ft.

Dry Hole _____

Abandoned _____

Date

JUL 20 1938 19

H. D. Hatfield Scout