


Map No. _____ Sec. 24 Twp. 27 R. 8
 Well No. 2 Shelbock Farm _____
Empire Company _____
 NORTH

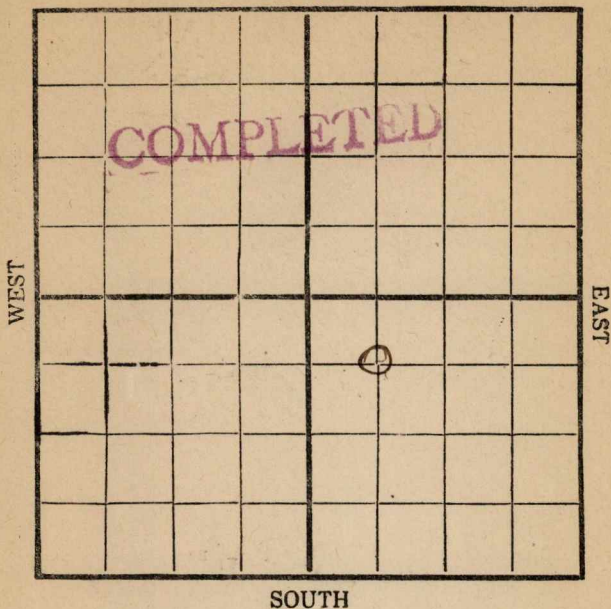

Location _____

Rig Up _____

Drilling Remarks:

Drilling Remarks:

RECORD

PRODUCTION

Cased _____ in. _____ ft.

1st 24 hrs. Nat. _____

Sand _____

1st 24 hrs. after shot _____

Gas _____

Gas _____ cu. ft.

Oil _____

Dry Hole _____

Total Depth _____


Abandoned _____

Map No. K10 Sec. 24 Twp. 27 R. 8
 Well No. 2 Shelby
Empire Company
 Contractor

NORTH

WEST

EAST

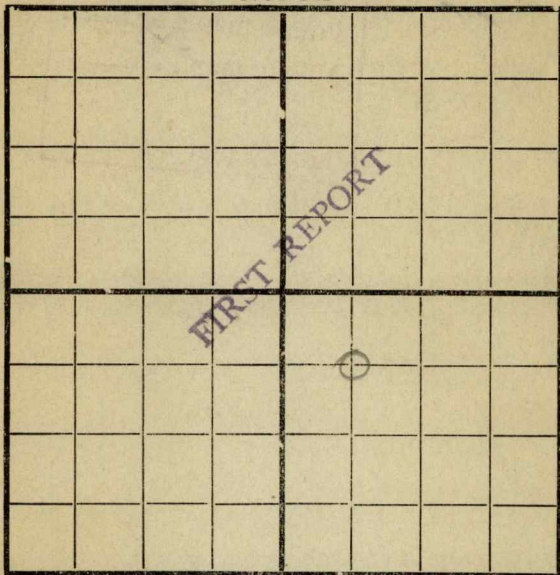

SOUTH

660 N-W

Location _____

Rig up _____

Drilling and Remarks:

80'

RECORD

Cased _____ in., _____ ft.

Sand _____

Gas _____

Oil _____

Total Depth _____

PRODUCTION

1st 24 hrs. Nat. _____

1st 24 hrs. after shot _____

Gas _____ Cu. Ft.

Dry Hole _____

Abandoned _____

Date

8/6 1919 Cy b Scout

Map No. K10 Sec. 24 Twp. 27 R. 8Well No. 2 ShellbackEmpire Company

Contractor

SECTION PLAT

660 Ft. from N. Line

Ft. from S. Line

Ft. from E. Line

660 Ft. from W. Line

		6	

Location

Rig up

Drilling and Remarks:

RECORD

Cased in., ft.

Sand

Gas 1103-1116

Oil

Total Depth

PRODUCTION

1st 24 hrs. Nat.

1st 24 hrs. after shot

Gas 7,200,000 Cu. Ft.

Dry Hole

Abandoned

Date

Pyle

9/28 1919

Scout