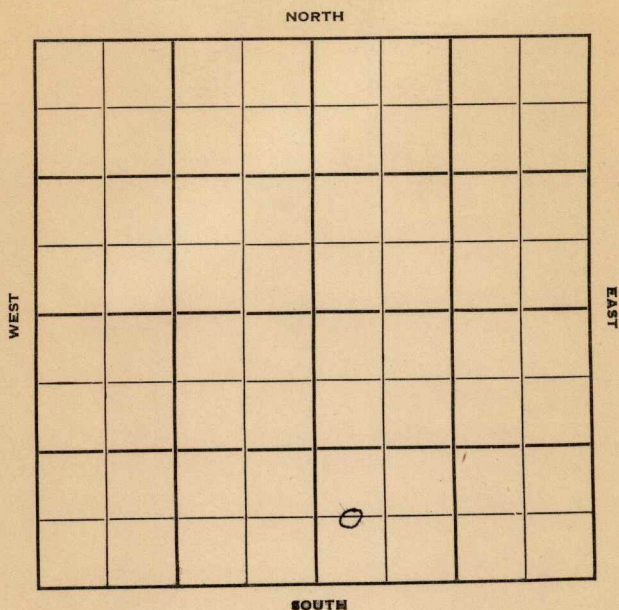


Section 25 Township 27 Range 8-EWell No. #2 HendersonCompany L K Jones

KANSAS

Greenwood

8-E ✓

Sec. 25 Twp. 27 R. 8-E

Well No. #2 Henderson Farm

L K Jones Company

Contractor

Ft. from N. Line

660


Ft. from S. Line

Ft. from E. Line

330

Ft. from W. Line

C W L SW SE

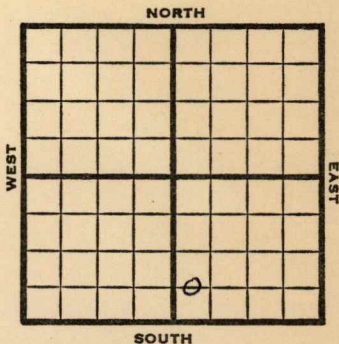

1950

?

REPORT

10/18 Cellar & Pits

11/29 Abandoned location

ABANDONED

County Greenwood State KansasSec. 25 (Blk.) 27 (Sur.) 8E Map No.Operator L. K. JonesWell No. 2 Farm HendersonElev. Location C W L SW SE

FIRST REPORT

0

660 Ft. From S Line SE330 Ft. From W Line Quarter1st. Report OCT 18 1950


Completion

Remarks

Spudding Date

Drlg. Data

Cellar & pits

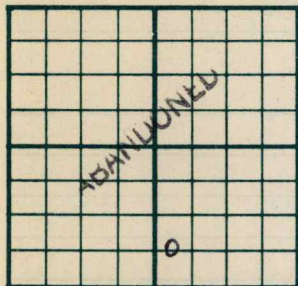County Greenwood State KansasSec. 25 (Blk.
Twp.) 27 (Sur.
Rge.) 8E Map No. _____Operator L. K. JonesWell No. 2 Farm HendersonElev. _____ Location C W L SW SE660 Ft. From S Line SE330 Ft. From W Line Quarter

1st. Report _____

Completion NOV 29 1950

Remarks _____

Spudding Date _____

Drlg. Data _____

Abd. location _____

J. E. TYRA