


Cowley

Section 4 Township 32 Range 3-E

Well No. 1 I. A. Wilson


Company Texas

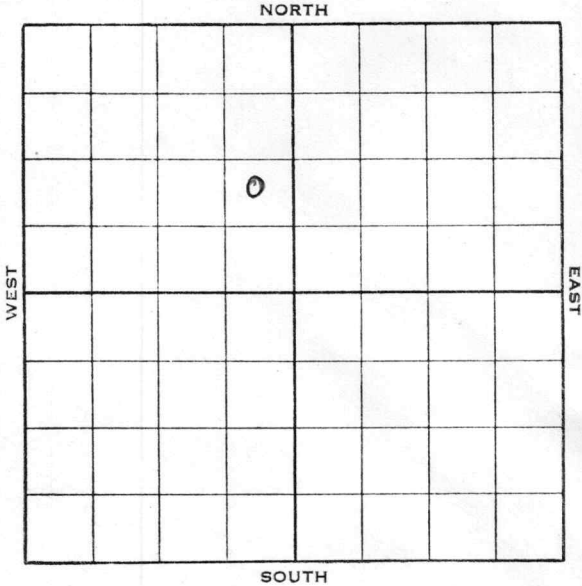

Sec. 4 Twp. 32 R. 3-E

Well No. #1 I. A. Wilson Farm
Texas Company

 Ft. from N. Line
978 Ft. from S. Line
330 Ft. from E. Line
 Ft. from W. Line
 Elev. 1190

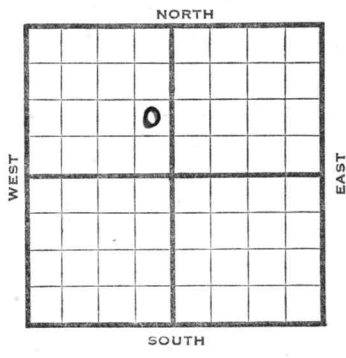

1938	REPORT
5/4	Location
5/12	"
5/20	"
5/27	"
6/3	"
6/10	"
6/17	"
6/24	"
7/1	"
7/8	"
7/15	"
7/22	"
7/29	"
8/5	R U R
8/12	10" - 82'. Dlg. 1320'.
8/19	K.C. 2474'. Dlg. 2623'.
8/26	Miss. 3007'. T.D. 3010'.
	7" - 3007'. RUST.
9/2	Dlg. 3080'.
9/9	Arb. 3232' T.D. Flow 1 bbls. per hour.

OVER

1938

9/16 T.D. 3250'. 1000 acid.
Testing.

9/21 7" at 3009'.

Arb. 3232'.

T. D. 3250'.

1000 acid.

Pump 283 bbls. 4 hrs. & 278 bbls.
4 hrs.

Potential 1670 bbls.

COMPLETED

Map No. Sec. 4 Twp. 32 R. 3E

Well No. 1 I. A. Wilson

Texas

Company _____

Contractor _____

FIRST REPORT

NE SE NW

SECTION PLAT

_____ Ft. from N. Line

978 Ft. from S. Line

330 Ft. from E. Line

_____ Ft. from W. Line

	0		

Location X

RECORD

Rig up _____

Drilling and Remarks:

Cased _____ in., _____ ft.

Sand _____

Gas _____

Oil _____

Total Depth _____

PRODUCTION

1st 24 hrs. Nat. _____

1st 24 hrs. after shot _____

Gas _____ Cu. Ft.

Dry Hole _____

Abandoned _____

Date

MAY 4 - 1938

19

H. D. Hatfield

Scout

