


Section 25 Township 27 Range 8E

Well No. #1 Hendrickson

Company L.K. Jones

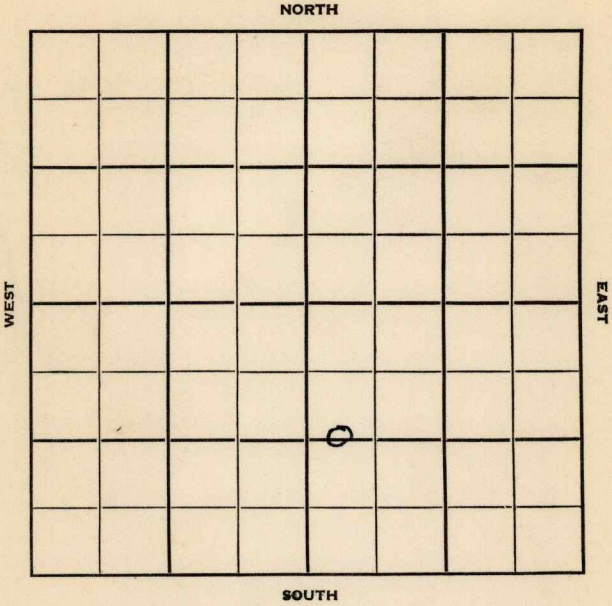

Greenwood

KANSAS

Sec. 25 Twp. 27 R. 8E

Well No. #1 Hendrickson Farm

L. K. Jones Company

Contractor

Beaumont Pool


1320 Ft. from N. Line

Ft. from S. Line

Ft. from E. Line

330 Ft. from W. Line

C W L W/2 SE

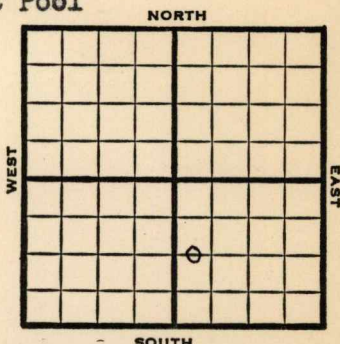

1952

REPORT

1/2

Oil Well TD 1836
Sand 1824 TD 1836
5" @ 1825
Comp. 15 BOPD

FIRST REPORT

+


COMPLETED

County Greenwood State Kansas
 Sec. 25 (Blk. 27 (Sur. 8E Map No.

Operator L. K. Jones

Well No. 1 Farm Hendrickson

Elev. Location 1C W L W $\frac{1}{2}$ SE

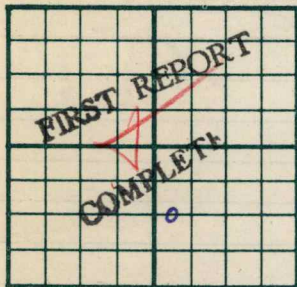

1320 Ft. From N Line SE

330 Ft. From W Line Quarter

1st. Report JAN 2 1952

Completion JAN 2 1952

Remarks Beaumont Pool

Spudding Date

Drlg. Data Oil well TD 1836

Sand 1824 TD 1836 5" @ 1825

Comp. 15 bopd

J. E. TYRA