

# KANSAS

Form 51-5M-7-39-Palace


Greenwood

Section 25 Township 27 Range 8-E

Well No. #1 Hendrickson

Company K. T. Weideman

NORTH Beaumont Pool

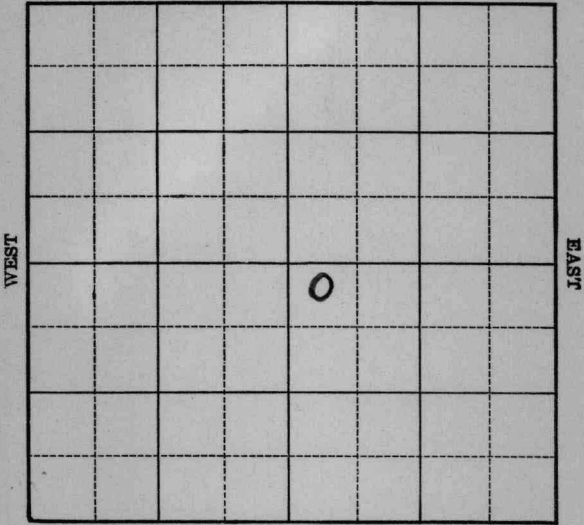

SOUTH

Sec. 25 Twp. 27 R. 8-E

Well No. #1 Hendrickson Farm

K. T. Weideman Company


(Beaumont)

250 Ft. from N. Line

\_\_\_\_\_ Ft. from S. Line

\_\_\_\_\_ Ft. from E. Line

330 Ft. from W. Line

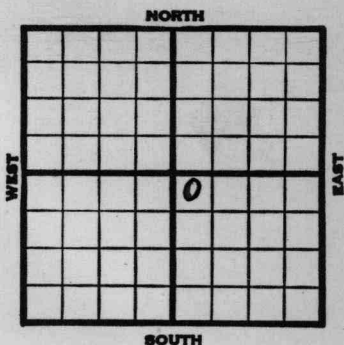

1939	REPORT
10/18	Machine.
10/26	Spud & SD.
11/2	" "
11/9	12" - 424' Drlg. 560'
11/16	10" - 840' Drlg.
11/23	10" - 846' Drlg. 1050'
11/29	1120' cement cave.
12/7	Shut down.
12/14	Drlg. 1365'
12/21	SD 1375'
12/28	" "
1940	
1/4	" "
1/11	Peru 1817' SD.
1/18	" " "
1/25	Base Peru 1852' T.D. 1965'
	Run 5" .
2/1	" " "
2/8	5" - 1952' Drlg. 2125'
2/15	Miss. 2392' 5" - 2394'
	Drlg. 2435'

1940  
2/23 SD 2445'  
2/29 Drlg. 2645'  
3/8 Base Miss. 2669' Viola 2710'  
SO 2733' Pay 2743-44' T.D.  
1200' oil over-night.  
3/14 Arb. <sup>2737</sup>~~2735~~'  
TD 2744' SD.  
3/20 Arb. 2737'  
T.D. 2744'  
1000 acid.  
5" - 2737'  
Pump 40 bbls.

COMPLETED

Map No. 10 Sec. 25 Twp. 27 R. 8E

Well No. 1 Hendrickson

K. T. Weideman Company

Contractor

FIRST REPORT

NW SE

250 Ft. from N. Line

\_\_\_\_\_ Ft. from S. Line

\_\_\_\_\_ Ft. from E. Line

330 Ft. from W. Line

SECTION PLAT

		o	

BEAUMONT POOL

Location \_\_\_\_\_

Rig up \_\_\_\_\_

Drilling and Remarks:

Machine

RECORD

Cased \_\_\_\_\_ in., \_\_\_\_\_ ft.

Sand \_\_\_\_\_

Gas \_\_\_\_\_

Oil \_\_\_\_\_

Total Depth \_\_\_\_\_

PRODUCTION

1st 24 hrs. Nat. \_\_\_\_\_

1st 24 hrs. after shot \_\_\_\_\_

Gas \_\_\_\_\_ Cu. Ft.

Dry Hole \_\_\_\_\_

Abandoned \_\_\_\_\_

Date

OCT 18 1939

19

S. J. LEWIS

Scout

Map No. 10 Sec. 25 Twp. 27 R. 8E

Well No. 1 Hendrickson

K. T. Weideman Company

Contractor

**COMPLETED**

**SECTION PLAT**

**NW SE**

		o	

250 Ft. from N. Line

\_\_\_\_\_ Ft. from S. Line

\_\_\_\_\_ Ft. from E. Line

330 Ft. from W. Line

**BEAUMONT POOL**

Location \_\_\_\_\_

Rig up \_\_\_\_\_

Drilling and Remarks:

*Ar 2737*

*100 acid*

*5" @ 2737*

*40 x 8 1/2 Pump*

**RECORD**

Cased \_\_\_\_\_ in., \_\_\_\_\_ ft.

Sand \_\_\_\_\_

Gas \_\_\_\_\_

Oil \_\_\_\_\_

Total Depth 2744

**PRODUCTION**

1st 24 hrs. Nat. \_\_\_\_\_

1st 24 hrs. after shot \_\_\_\_\_

Gas \_\_\_\_\_ Cu. Ft.

Dry Hole \_\_\_\_\_

Abandoned \_\_\_\_\_

Date

MAR 20 1940 19

S. J. LEWIS Scout