


Section 4 Township 32 Range 3-E

Well No. 5 "A" Wilson

Company Earl Wakefield

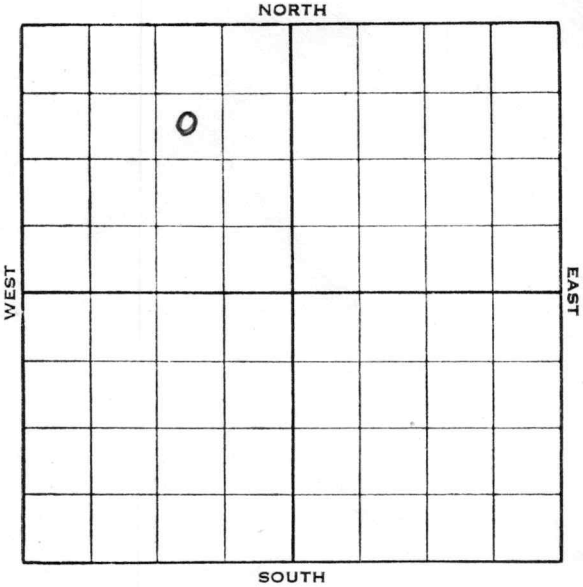

Sec. 4 Twp. 32 R. 3-E

Well No. #5 "A" Wilson Farm  
Earl Wakefield Company


990 Ft. from N. Line

\_\_\_\_\_ Ft. from S. Line

990 Ft. from E. Line

\_\_\_\_\_ Ft. from W. Line

Elev. 1194

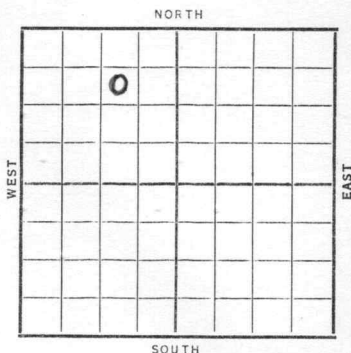

Date	REPORT
1938	
7/20	C. R.
7/29	"
8/5	20" - 88'. Dlg. 260'.
8/12	15" - 560'. Dlg. 1275'.
8/19	SD 1275' for csg.
8/26	12" - 1293'. 8" - 1830'.
	Dlg. 2010'.
9/2	8" - 2190'. K. C. 2473'.
	Drlg. 2480'.
9/9	S.S.O. 2508'. H.F.W. 2512-15'.
	8" - 2570'. Dlg. 2701'.
9/16	Miss. 3091'. T. D. 3245'.
	6" - 3245'.
9/23	Arb. 3249-70' T.D.
	Pump & flow 420 oil in 4 hrs.
	S.D. repairs.
9/30	On potential.

OVER

1938

10/5

6" at 3245'.

Arb. 3249'.

T. D. 3270'.

1000 acid.

Potential 3002 bbls., Pump.

COMPLETED

Cowley KANSAS

Map No. 1 Sec. 4 Twp. 32 R. 3E

Well No. 5"A" Wilson

Earl Wakefield Company

Contractor

FIRST REPORT

SW NE NW

990 Ft. from N. Line

\_\_\_\_\_ Ft. from S. Line

990 Ft. from E. Line

\_\_\_\_\_ Ft. from W. Line

SECTION PLAT

	0		

Location \_\_\_\_\_

Rig up \_\_\_\_\_

Drilling and Remarks:

CR

RECORD

Cased \_\_\_\_\_ in., \_\_\_\_\_ ft.

Sand \_\_\_\_\_

Gas \_\_\_\_\_

Oil \_\_\_\_\_

Total Depth \_\_\_\_\_

PRODUCTION

1st 24 hrs. Nat. \_\_\_\_\_

1st 24 hrs. after shot \_\_\_\_\_

Gas \_\_\_\_\_ Cu. Ft.

Dry Hole \_\_\_\_\_

Abandoned \_\_\_\_\_

Date

JUL 20 1938 19

H. D. Hatfield

Scout

Cowley KANSAS

Map No. / Sec. 4 Twp. 32 R. 3E

Well No. 5"A"Wilson

Earl Wakefield Company

Contractor

COMPLETED

SECTION PLAT

	0		

SW NE NW

990 Ft. from N. Line

Ft. from S. Line

990 Ft. from E. Line

Ft. from W. Line

Location

Rig up

Drilling and Remarks:

1000 acid

Pot 3002

Pump

RECORD

Cased 6 in., 3245 ft.

Sand Arb 3249

Gas

Oil

Total Depth 3270

PRODUCTION

1st 24 hrs. Nat.

1st 24 hrs. after shot

Gas Cu. Ft.

Dry Hole

Abandoned

Date

OCT 5 - 1938 19

H. D. Hatfield Scout