


Cowley

Map No. KANSAS Sec. 8 Twp. 32 R. 3E

Well No. 1 Carson Farm
Earl Wakefield et al Company

NORTH

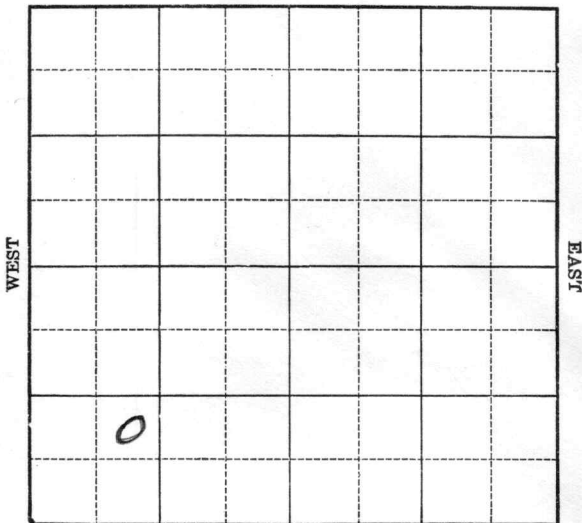

SOUTH

Location _____

Drilling Remarks _____

Rig Up _____

Drilling Remarks _____

RECORD

Cased _____ in. _____ ft.

Sand _____

Gas _____

Oil _____

Total Depth _____

PRODUCTION

1st 24 hrs. Nat. _____

1st 24 hrs. after shot _____

Gas _____ cu. ft.

Dry Hole _____

Abandoned _____

Cowley

Map No. KANSAS Sec. 8 Twp. 32 R. 3E


Well No. 1 Carson Farm
Earl Wakefield et al Company

_____ Ft. from N. Line

990 Ft. from S. Line

_____ Ft. from E. Line

990 Ft. from W. Line

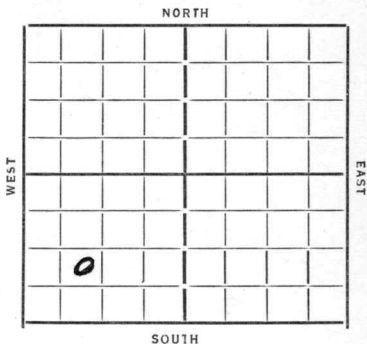

Date 1954

REPORT

- 10/24 Location
- 11/1 Bldg. Rig
- 11/8 RW
- 11/15 Bly 465
- 11/22 1 1/2 WR 1248
- 11/28 Bly 1560
- 12/6 10" 1827 Staluskur 2180
Bly 2195
- 12/13 HFW 2282 8" 2309
KC 2630 Bly 2675
- 12/21 Run 6" 3182
- 12/27 3364 C.O.
- 1955
- 1/2 K.C. 2630 Siliceous 3555
TD 3556 D & A

ABANDONED

Map No. 1 Sec. 8 Twp. 32 R. 3E

Well No. 1 - Carson

Earl Wakefield et al Company

Contractor

FIRST REPORT

SECTION PLAT

_____ Ft. from N. Line

990 Ft. from S. Line

_____ Ft. from E. Line

990 Ft. from W. Line

Location ✓

Rig up _____

Drilling and Remarks:

RECORD

Cased _____ in., _____ ft.

Sand _____

Gas _____

Oil _____

Total Depth _____

PRODUCTION

1st 24 hrs. Nat. _____

1st 24 hrs. after shot _____

Gas _____ Cu. Ft.

Dry Hole _____

Abandoned _____

Date

10-27-37 1937 ORVAL MANNSCHRECK Scout

Map No. 1 Sec. 8 Twp. 32 R. 3E

Well No. 1-Carson

Earl Wakefield Company

Contractor

ABANDONED

SECTION PLAT

.....Ft. from N. Line

990 Ft. from S. Line

.....Ft. from E. Line

990 Ft. from W. Line

RECORD

Location.....

Cased.....in.,.....ft.

Rig up.....

Sand K.C. 2630

Drilling and Remarks:

Gas silicious 3553

Oil.....

Total Depth 3556

PRODUCTION

1st 24 hrs. Nat.....

1st 24 hrs. after shot.....

Gas.....Cu. Ft.

Dry Hole.....

Abandoned.....

NOT FT

Date

1-2-35 192.....

ORVAL MANNSCHRECK

Scout