
Cowley KANSAS

SECTION 8 TOWNSHIP 32 RANGE 3 E

WELL NO. #1 Nixon

COMPANY McNeish & Garlapp

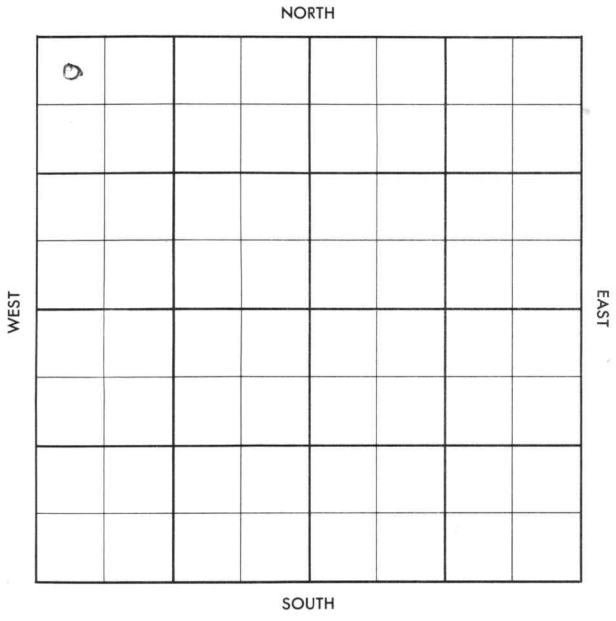

FORM 504-3 SUNRAY

Cowley KANSAS

SEC.	TWP.	R.
8	32	3E

WELL NO.

#1 Nixon FARM

COMPANY

McNeish & Gralapp

CONTRACTOR

WILDCAT


_____ Ft. from N. Line

_____ Ft. from S. Line

_____ Ft. from E. Line

_____ Ft. from W. Line

NW NW NW

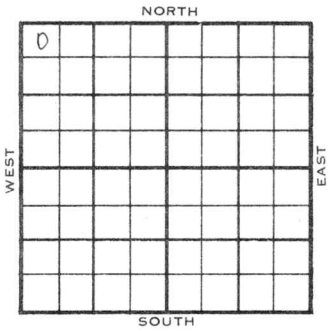

1956	ELEVATION 1157	REPORT
3-14	Comm. 3-7-56 8" @ 118/100 Drlg. 1890	
4-11	5½" @ 2643/75 CO to 2700 Wtr. D & A Stal 2172 Layton 2585 KC 2630 Oswego 2894 Chert 3142 TD 3150	

ABANDONED

DX-78

FORM 513 REV. SUNRAY

County Cowley Elev.

Sec. 8 Twp. 32 Rge. 3E

Company McNeish & Gralapp

Farm Name Nixon No. 1

TOPS	DEPTH	LOG	DATUM
Anh.			
T.P.			
H.			
Tr.			
Dg.			
B.L.			
L.			
K.C.			
B.K.C.			
Ce.			
C.			
M.			
M.			
K.			
Mz.			
Mo.			
V.			
S.			
S.			
A			
R.			
P€.			
G.			
T.D.			

Loc. in Sec. NW NW NW

Geol.

Contr.

Pool Wildcat



Date Comm. 3-7-56

8" @ 118/100 drlg. 1890

Co. Lse. No. Sec. T. R.

FORM 513 REV. SUNRAY

County Cowley Elev. 1157

Sec. 8 Twp. 32 Rge. 3E

Company McNeish & Gralapp

Farm Name Nixon No. 1

TOPS	DEPTH	LOG	DATUM
Anh.			
Tp.			
H.			
Tr.			
Dg.			
Bl. Stal	2172		1015
L. Layton	3585		1428
K.C.	2630		1473
B.K.C. Oswego	2894		1737
Ce.			
C.			
M. Chert	3142		1985
M.			
K.			
Mz.			
Mq.			
V.			
S.			
S.			
A			
R.			
P€.			
G.			
T.D.	3150		

Loc. in Sec. NW NW NW

Geol.

Contr.

Pool Wildcat



Date Comm. 3-7-56 APR 11 1956

8" @ 118/100 5½" @ 2643/75 CO to 2700

wtr.

D & A

Co. Lse. No. Sec. T. R.