


Map No. Kansas Sec. 9 Twp. 32 R. 3^E

Well No. 1 Wilson Farm
Ark, Fuel Co. Company

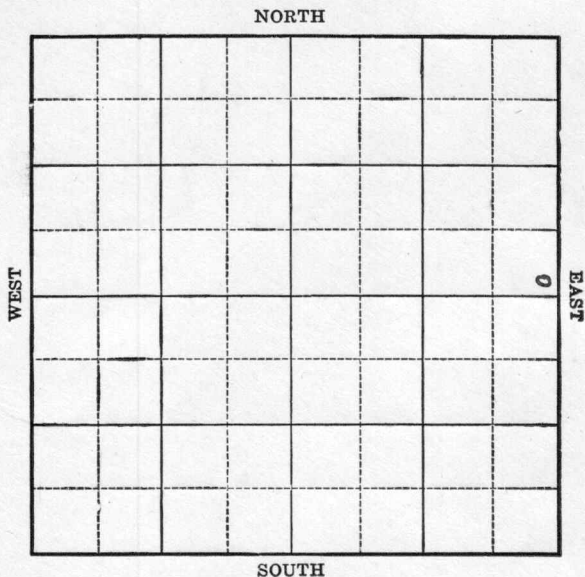

Location _____

Drilling Remarks:

RECORD

Cased _____ in. _____ ft.

Sand _____

Gas _____

Oil _____

Total Depth _____

Rig Up _____

Drilling Remarks:

PRODUCTION

1st 24 hrs. Nat. _____

1st 24 hrs. after shot _____

Gas _____ cu. ft.

Dry Hole _____

Abandoned _____

Map No. Kansas Sec. 9 Twp. 32 R. 3E

Well No. 1 Wilson Farm


Ark Fuel Company

..... Ft. from N. Line

300 Ft. from S. Line

300 Ft. from E. Line

..... Ft. from W. Line

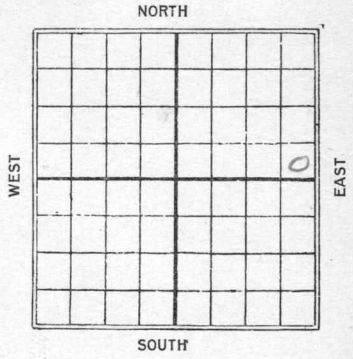

Remarks

Date	REPORT
<u>1925</u>	
<u>4/28</u>	<u>Location</u>
<u>6/2</u>	<u>Reg</u>
<u>7/5</u>	<u>315</u>
<u>7/22</u>	<u>S.D. 2585'</u>
<u>7/29</u>	<u>1150 S.D. ref bailer</u>
<u>8/17</u>	<u>_____</u>
<u>8/14</u>	<u>1575</u>
<u>8/19</u>	<u>1750'</u>
<u>8/27</u>	<u>pipe trouble 1780'</u>
<u>9/2</u>	<u>sand 1855-1915 Haly 2220</u>
<u>9/9</u>	<u>3090 top line 6" set</u>
<u>9/16</u>	<u>Haly 3100</u>
<u>9/24</u>	<u>✓ 3250</u>
<u>10/6</u>	<u>S. & A. 3500</u>

Map No. **KANSAS** Sec. 9 Twp. 32 R. 3E

Well No. 1 Wilson

Grk Fuel Company

Contractor

FIRST REPORT

SECTION PLAT

----- Ft. from N. Line

300 Ft. from S. Line

300 Ft. from E. Line

----- Ft. from W. Line

			o

Location ✓✓

Rig up -----

Drilling and Remarks:

RECORD

Cased ----- in., ----- ft.

Sand -----

Gas -----

Oil -----

Total Depth -----

PRODUCTION

1st 24 hrs. Nat. -----

1st 24 hrs. after shot -----

Gas ----- Cu. Ft.

Dry Hole -----

Abandoned -----

Date **APR 28 1925**

M. A. BENEAR

----- 192 ----- Scout

KI

KANSAS

Map No. _____ Sec. 9 Twp. 32 R. 31

Well No. 1 Wilson

Asp Fuel Company

Contractor

SECTION PLAT

_____ Ft. from N. Line

330 Ft. from S. Line

330 Ft. from E. Line

_____ Ft. from W. Line

			0

ABANDONED

Location _____

Rig up _____

Drilling and Remarks:

T.A 3500

T & A.

RECORD

Cased _____ in., _____ ft.

Sand _____

Gas _____

Oil _____

Total Depth _____

PRODUCTION

1st 24 hrs. Nat. _____

1st 24 hrs. after shot _____

Gas _____ Cu. Ft.

Dry Hole _____

Abandoned _____

Date

OCT 6 1925

S. J. LEWIS

Scout

MAP NO. _____ SEC. 9 TWP. 32S3E R. _____

WELL NO. 1 below
Asp Fuel COMPANY _____

CONTRACTOR _____

SECTION PLAT

			①

_____ FT. FROM N. LINE

_____ FT. FROM S. LINE

_____ FT. FROM E. LINE

_____ FT. FROM W. LINE

RECORD

LOCATION _____

CASED _____ IN., _____ FT.

RIG UP _____

SAND _____

DRILLING AND REMARKS:

GAS _____

OIL _____

TOTAL DEPTH 3500

OK

PRODUCTION

1ST 24 HRS. NAT. _____

1ST 24 HRS. AFTER SHOT _____

GAS _____ Cu. Ft.

DRY HOLE

ABANDONED

DATE

10/13 1925

SCOUT