


Section 25 Township 27 Range 8E

Well No. #2 Hendrickson

Company L. K. James

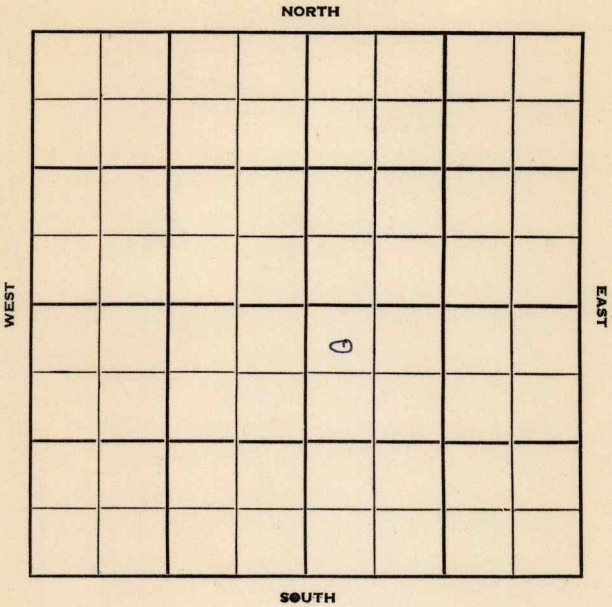

Greenwood

KANSAS

Sec. 25 Twp. 27 R. 8E

Well No. #2 Hendrickson Farm

L. K. James Company

James - Contr. Contractor


400' Ft. from N. Line

_____ Ft. from S. Line

_____ Ft. from E. Line

330' Ft. from W. Line

NW NW SE

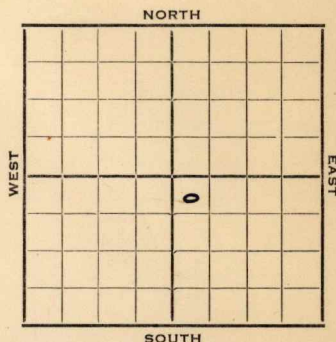

1952

Elev. -

REPORT

2/6

Spud 2-3-52

8" @ 45'

Shut down @ 100

2/13

Drlg. 1470'

3/26

Spud 2-3-52

Oil well TD 2742' 8" @ 45'

Peru 1840' Miss 2509'

Simp. 2729' TD 2734' 5" @ 2733'

Arb. 2741' TD 2742'

Comp. 25 BOPD

COMPLETED

County **Greenwood** State **Kansas**
Sec. **25** (Blk. **27** (Sur. **8E** Map No.

Operator **L. K. James**

Well No. **2** Farm **Hendrickson**

Elev. Location **NW NW SE**



400 Ft. From **N** Line **SE**

330 Ft. From **W** Line Quarter

1st. Report **FEB 6 1952**

Completion

Remarks

James - Contr.

Spudding Date **2-3-52**

Drlg. Data

8" @ 45' Shut down @ 100

J. G. McGEHEE

County Greenwood State Kansas
 Sec. 25 (Blk.) 27 (Sur.) 8E Map No.

Operator L. K. James

Well No. 2 Farm Hendrickson

Elev. Location NW NW SE



400 Ft. From N Line SE

330 Ft. From W Line Quarter

Ist. Report

Completion MAR 26 1952

Remarks

James - Contr.

Spudding Date 2-3-52

Drlg. Data Oil well TD 2742

8" @ 45 Peru 1840 Miss. 2509

Simp. 2729 TD 2734 5" @ 2733

Arb. 2741 TD 2742 Comp. 25 bopd