


KANSAS

Map No. _____ Sec. 14 Twp. 32 R. 3E

Well No. 1 - Ehmpke Farm _____
Elwood Oil Company

NORTH

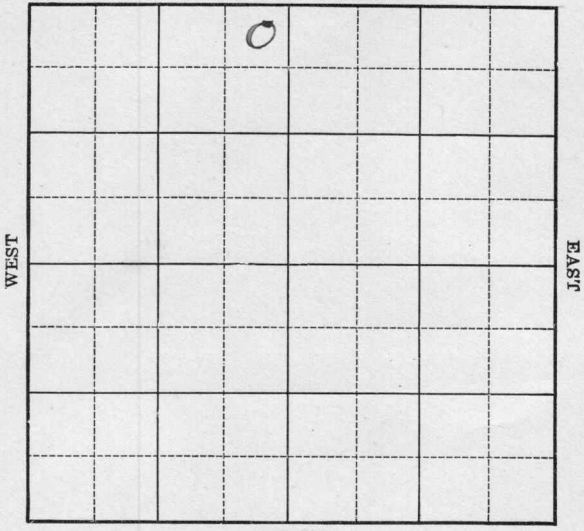

SOUTH

Location _____

Drilling Remarks _____

Rig Up _____

Drilling Remarks _____

RECORD

Cased _____ in. _____ ft.

Sand _____

Gas _____

Oil _____

Total Depth _____

PRODUCTION

1st 24 hrs. Nat. _____

1st 24 hrs. after shot _____

Gas _____ cu. ft.

Dry Hole _____

Abandoned _____

Map No. KANSAS Sec. 14 Twp. 32 R. 3E


Well No. 1 - Ahnke Farm
Edwood Oil Company

300 Ft. from N. Line

..... Ft. from S. Line

300 Ft. from E. Line

..... Ft. from W. Line

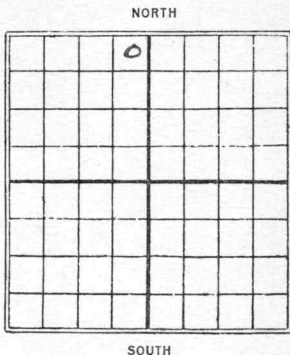

1928

Date

REPORT

Date	REPORT
4/18	Loc.
4/25	Rig
5/2	Rigging up-
5/9	Drlg - 415.
5/16	" 965
5/23	" 1328
5/31	" 1600
6/6	" 1690
6/13	" 1695
6/20	" 1820
6/27	" 1875
7/3	T.D. 2210 - "R.8"
7/11	Wrlg 2235
7/18	" 2650
7/25	" 2890
8/1	Top line 3175 - drlg 3180.
8/7	Drlg 3285
8/15	Wilson 3436-42
	Sil line 3446 H.F.W
	T.D. 3466 D. & A. 3466

Map No. **KANSAS** Sec. 14 Twp. 32 R. 3E

Well No. 1 Eganke

Elwood Oil Company

Contractor

SECTION PLAT

	0		

300 Ft. from N. Line

----- Ft. from S. Line

300 Ft. from E. Line

----- Ft. from W. Line

FIRST REPORTS

Location ✓ -----

Rig up -----

Drilling and Remarks:

RECORD

Cased ----- in., ----- ft.

Sand -----

Gas -----

Oil -----

Total Depth -----

PRODUCTION

1st 24 hrs. Nat. -----

1st 24 hrs. after shot -----

Gas ----- Cu. Ft.

Dry Hole -----

Abandoned -----

Date

APR 18 1928

192

S. J. LEWIS

Scout

MAP No. 1 **KANSAS** SEC. 14 TWP. 22 R. 2E

WELL No. 1 Elmke

Elmwood Oil COMPANY

CONTRACTOR

SECTION PLAT

300 FT. FROM N. LINE

FT. FROM S. LINE

300 FT. FROM E. LINE

FT. FROM W. LINE

ABANDONED

	0		

LOCATION _____

RIG UP _____

DRILLING AND REMARKS:

Philco of 8436-42

Sil. line 3446 HFW

Total Depth

3466

D & A

RECORD

CASED _____ IN. _____ FT.

SAND _____

GAS _____

OIL _____

TOTAL DEPTH _____

PRODUCTION

1ST 24 HRS. NAT. _____

1ST 24 HRS. AFTER SHOT _____

GAS _____ CU. FT.

DRY HOLE _____

ABANDONED _____

DATE

AUG 15 1928

S. J. LEWIS

192

SCOUT