

Sec. 25 Twp. 27 Range 8E

#1 Kofoid

Kansas Geological Society

Empire

Skelly Scout Tickets


Greenwood

Map No. *K10* Sec. *25* Twp. *27* R. *8*

Well No. *1* *Kopoid* Farm

Wichita Nat. Company

NORTH

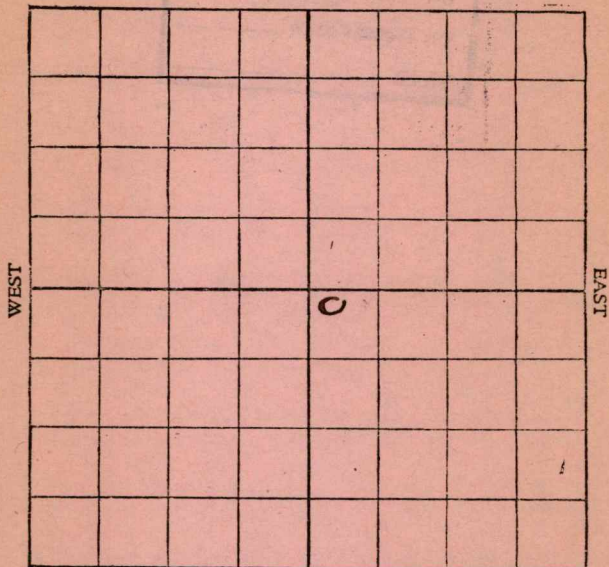

SOUTH

Location

Rig up

Drilling and remarks:

Loc.

RECORD

Cased in. Ft.

Sand

Gas

Oil

Total Depth

PRODUCTION

1st 24 hrs. Nat.

1st 24 hrs. after shot

Gas Cu. Ft.

Dry Hole

Abandoned

Date

5/12, 191*7*, *Crocker* Scout


Greenwood

Map No. _____ Sec. *25* Twp. *27* R. *8*

Well No. *1 Kofoid* Farm _____

_____ Company _____

NORTH

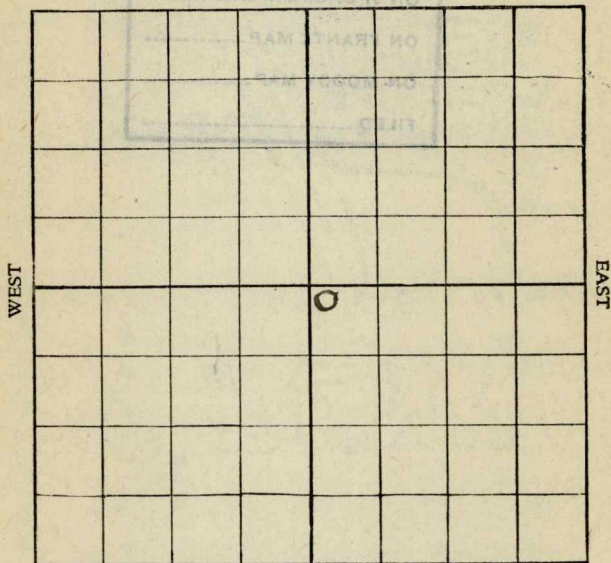

SOUTH

Location _____

Rig up _____

Drilling and remarks:

Loc.

RECORD

Cased _____ in. _____ Ft.

Sand _____

Gas _____

Oil _____

Total Depth _____

PRODUCTION

1st 24 hrs. Nat. _____

1st 24 hrs. after shot _____

Gas _____ Cu. Ft.

Dry Hole _____

Abandoned _____

Date


5/19, 19*17*, *Crocker* Scout

Map No. _____ Sec. 25 Twp. 24 R. 8

Well No. 1 Kofoid Farm _____

Emp Company _____

NORTH

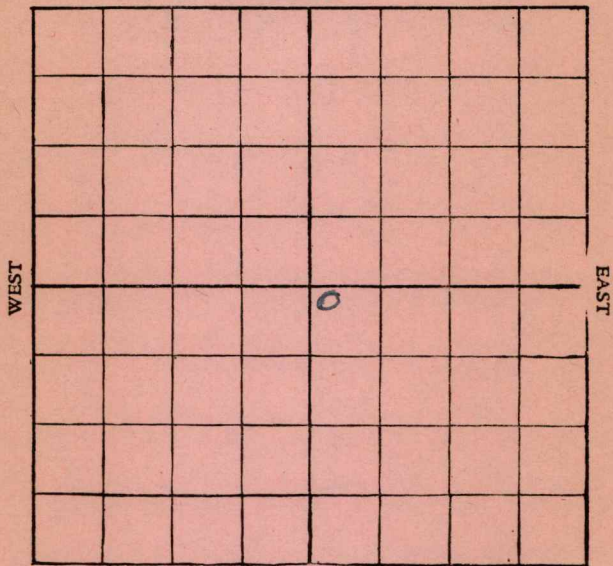

SOUTH

Location _____

Rig up _____

Drilling and remarks:

Loc.

RECORD

Cased _____ in. _____ Ft.

Sand _____

Gas _____

Oil _____

Total Depth _____

PRODUCTION

1st 24 hrs. Nat. _____

1st 24 hrs. after shot _____

Gas _____ Cu. Ft.

Dry Hole _____

Abandoned _____

Date


5/26, 1917, Drocker Scout

Map No. _____ Sec. 25 Twp. 27 R. 8Well No. 1 Kofoid Farm __________Emp. Company _____

NORTH

WEST

EAST

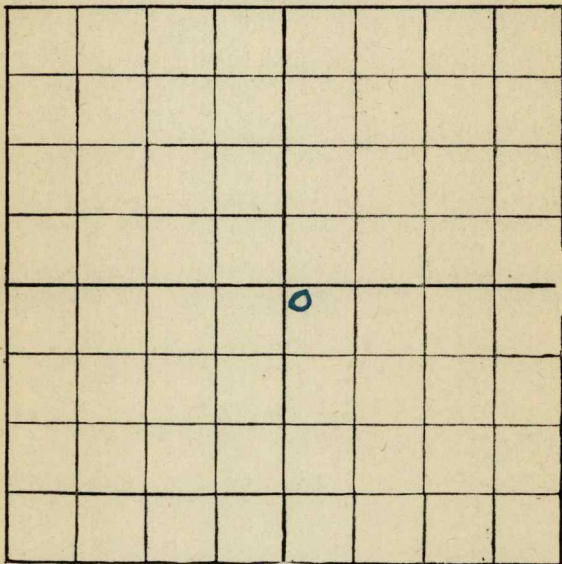

SOUTH

Location _____

Rig up _____

Drilling and remarks:

L. J. C.

RECORD

Cased _____ in. _____ Ft.

Sand _____

Gas _____

Oil _____

Total Depth _____

PRODUCTION

1st 24 hrs. Nat. _____

1st 24 hrs. after shot _____

Gas _____ Cu. Ft.

Dry Hole _____

Abandoned _____

Date

6/2

, 191

7 Brocker

Scout


Greenwood

Map No. _____ Sec. *25* Twp. *27* R. *8*

Well No. *1* *Kofoed* Farm

_____ *Emp* Company

NORTH

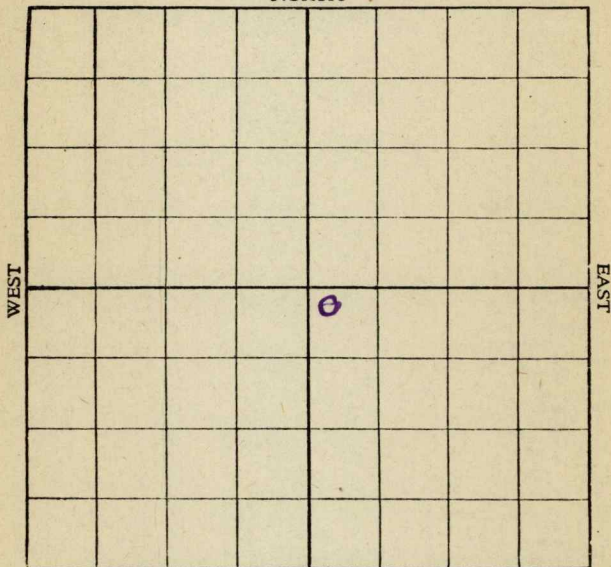

SOUTH

Location _____

Rig up _____

Drilling and remarks:

Loc.

RECORD

Cased _____ in. _____ Ft.

Sand _____

Gas _____

Oil _____

Total Depth _____

PRODUCTION

1st 24 hrs. Nat. _____

1st 24 hrs. after shot _____

Gas _____ Cu. Ft.

Dry Hole _____

Abandoned _____

Date


JUN 9 - 1917

C. J. Crocker

Scout

Map No. _____ Sec. 25 Twp. 27 R. 8Well No. 1 Kofoid Farm __________Emp. Company _____

NORTH

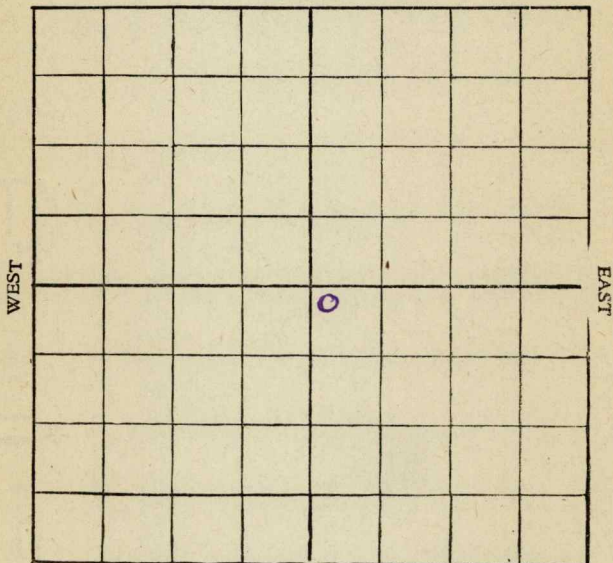

SOUTH

Location _____

Rig up ✓ _____

Drilling and remarks:

Rig

RECORD

Cased _____ in. _____ Ft.

Sand _____

Gas _____

Oil _____

Total Depth _____

PRODUCTION

1st 24 hrs. Nat. _____

1st 24 hrs. after shot _____

Gas _____ Cu. Ft.

Dry Hole _____

Abandoned _____


Date

JUN 16 1917, 191 _____, C. T. Crook Secut

Greenwood

Map No. _____ Sec. 25 Twp. 27 R. 8Well No. 1 Kofoid Farm _____Emp Company _____

NORTH

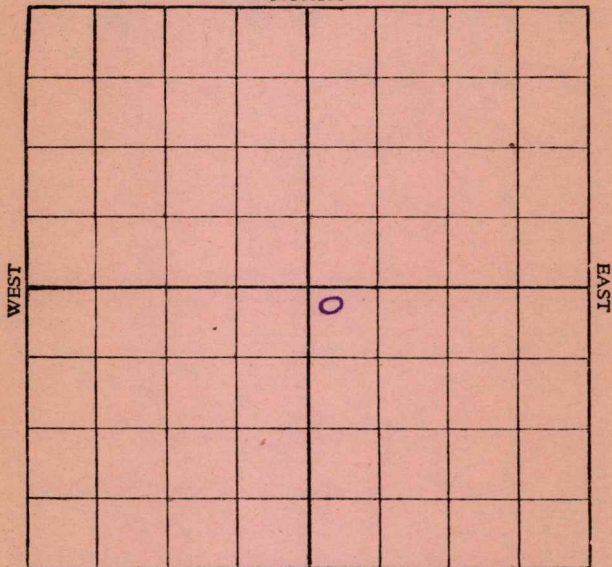

SOUTH

Location _____

Rig up _____

Drilling and remarks:

Rig.

RECORD

Cased _____ in. _____ Ft.

Sand _____

Gas _____

Oil _____

Total Depth _____

PRODUCTION

1st 24 hrs. Nat. _____

1st 24 hrs. after shot _____

Gas _____ Cu. Ft.

Dry Hole _____

Abandoned _____

Date


JUN 22 1917

_____, 191____,

E. J. Crocker Scout

Map No. _____ Sec. 25 Twp. 27 R. 8Well No. 1 _____ Farm _____Company Empire

NORTH

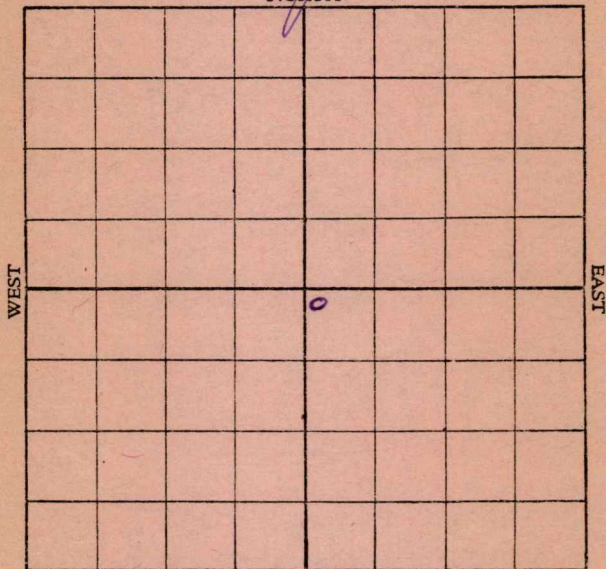

SOUTH

Location _____

Rig up _____

Drilling and remarks:

Rig

RECORD

Cased _____ in. _____ Ft.

Sand _____

Gas _____

Oil _____

Total Depth _____

PRODUCTION

1st 24 hrs. Nat. _____

1st 24 hrs. after shot _____

Gas _____ Cu. Ft.

Dry Hole _____

Abandoned _____

Date JUN 30 1917

, 191

Scout

Greenwood

Map No. _____ Sec. 25 Twp. 27 R. 8Well No. 1 Kofoed Farm_____
NORTH Emp Company

WEST

EAST

SOUTH

Location _____

Rig up. ☒ _____

Drilling and remarks:

RECORD

Cased _____ in. _____ Ft.

Sand _____

Gas _____

Oil _____

Total Depth _____

PRODUCTION

1st 24 hrs. Nat. _____

1st 24 hrs. after shot _____

Gas _____ Cu. Ft.

Dry Hole _____

Abandoned _____

Date

JUL 7 1917

, 191

G. T. Crocker.

Scout

Greenwood

Map No. _____

Sec. 25Twp. 27R. 8Well No. 1


Farm

Company

NORTH

WEST

EAST

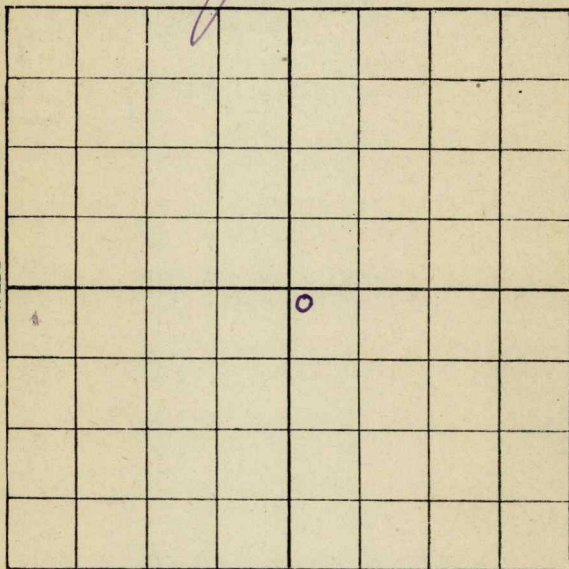

SOUTH

Location _____

Rig up _____

Drilling and remarks:

D-300

RECORD

Cased _____ in. _____ Ft.

Sand _____

Gas _____

Oil _____

Total Depth _____

PRODUCTION

1st 24 hrs. Nat. _____

1st 24 hrs. after shot _____

Gas _____ Cu. Ft.

Dry Hole _____

Abandoned _____

Date

JUL 14 1917

191

G. T. Crocker.

Scout


Map No. _____ Sec. 25 Twp. 27 R. 8Well No. 17 Farm _____

Company _____

NORTH

WEST

EAST

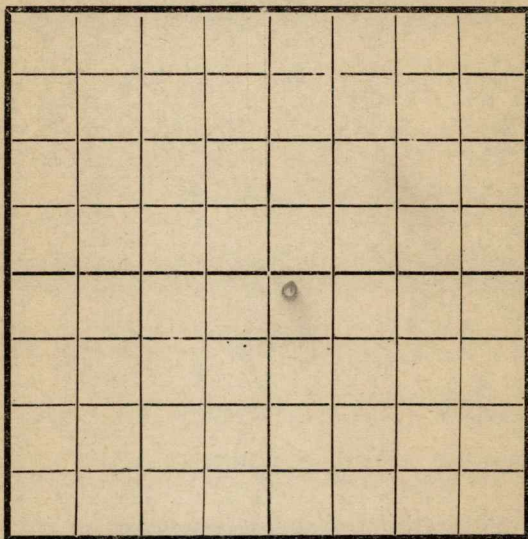

SOUTH

Location _____

Rig Up _____

Drilling and remarks

600'

RECORD

Cased _____ in. _____ Ft.

Sand _____

Gas _____

Oil _____

Total Depth _____

PRODUCTION

1st 24 hrs. Nat. _____

1st 24 hrs. after shot _____

Gas _____ Cu. Ft.

Dry Hole _____

Abandoned _____

Date


7/19, 1917 Carly Scout

Map No. K-10 Sec. 25 Twp. 27 R. 8
 Well No. 1. C. Kofoid Farm
Com pine Company

NORTH

WEST

EAST

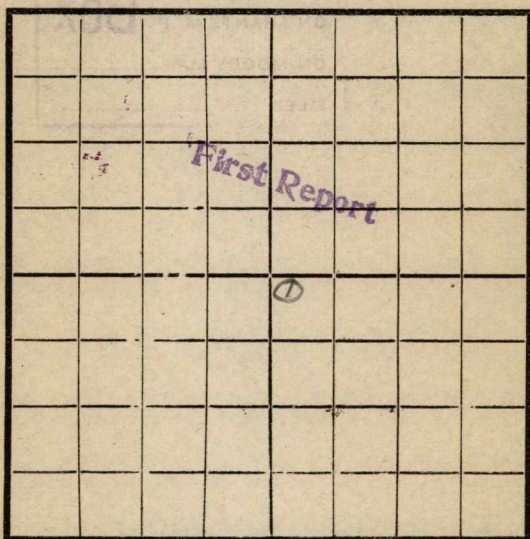

SOUTH

Location -----

Rig Up -----

Drilling and remarks

at 990.

RECORD

Cased ----- in. ----- Ft.

Sand -----

Gas -----

Oil -----

Total Depth -----

PRODUCTION

1st 24 hrs. Nat. -----

1st 24 hrs. after shot -----

Gas ----- Cu. Ft.

Dry Hole -----

Abandoned -----

Date

8-20, 1917 Lantz Scout

Map No. _____ Sec. 25 Twp. 27 R. 8Well No. 1. Rofoid Farm _____

Company _____

Greenwood NORTH

WEST

EAST

SOUTH

Location _____

Rig Up _____

Drilling and remarks,

D. D. 990'
for csq

RECORD

Cased _____ in. _____ Ft.

Sand _____

Gas _____

Oil _____

Total Depth _____

PRODUCTION

1st 24 hrs. Nat. _____

1st 24 hrs. after shot _____

Gas _____ Cu. Ft.

Dry Hole _____

Abandoned _____

Date


8-31-1917 Lantz Scout

Map No. _____ Sec. 75 Twp. 27 R. 8Well No. L. R. R. 1050 Farm _____Omaha Company _____

NORTH

WEST

EAST

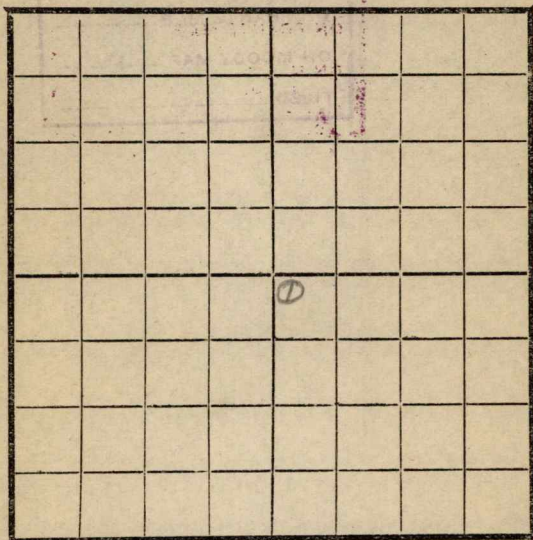

SOUTH

Location _____

Rig Up _____

Drilling and remarks

at 1050.

RECORD

Cased _____ in. _____ Ft.

Sand _____

Gas _____

Oil _____

Total Depth _____

PRODUCTION

1st 24 hrs. Nat. _____

1st 24 hrs. after shot _____

Gas _____ Cu. Ft.

Dry Hole _____

Abandoned _____

Date


9-5, 1917

Scout _____

Map No. _____ Sec. 25 Twp. 27 R. 8Well No. 1 Farm _____Engine Company _____

NORTH

WEST

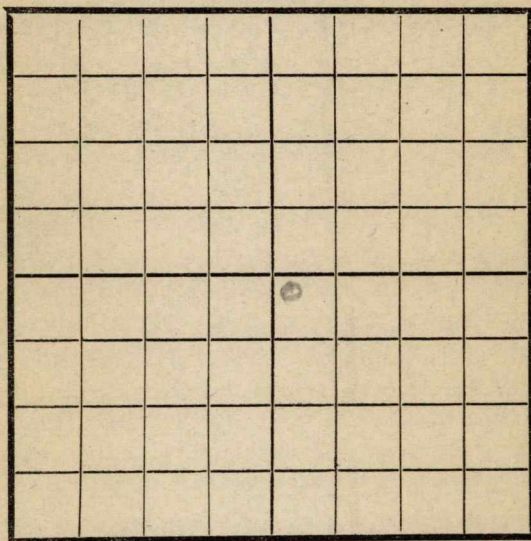

EAST

SOUTH

Location _____

Rig Up _____

Drilling and remarks

Shut Down990Greenwood
Co

RECORD

Cased _____ in. _____ Ft.

Sand _____

Gas _____

Oil _____

Total Depth _____

PRODUCTION

1st 24 hrs. Nat. _____

1st 24 hrs. after shot _____

Gas _____ Cu. Ft.

Dry Hole _____

Abandoned _____


Date

10/24, 1917 Condy Scout _____

Map No. _____ Sec. 25 Twp. 27 R. 8EWell No. 1 Koford Farm _____
Engine Company _____

NORTH

WEST

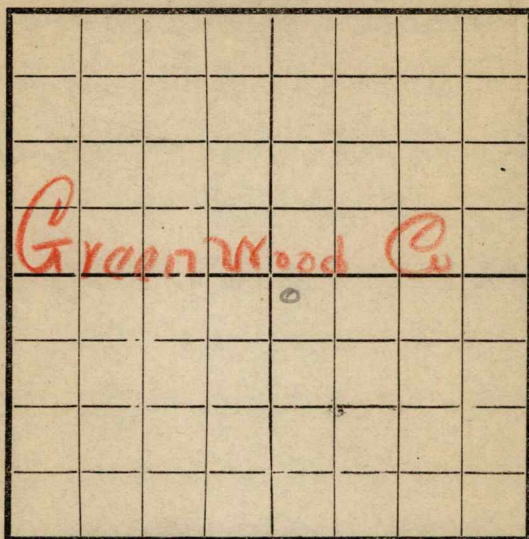

EAST

SOUTH

Location _____

Rig Up _____

Drilling and remarks

Shot Down 990

RECORD

Cased _____ in _____ Ft.

Sand _____

Gas _____

Oil _____

Total Depth _____

PRODUCTION

1st 24 hrs. Nat. _____

1st 24 hrs. after shot _____

Gas _____ Cu. Ft.


Dry Hole _____

Abandoned _____

Date

1731, 1917 Cordiff Scout

Map No. _____ Sec. 25 Twp. 27 R. 8
 Well No. 1 Kofoid Farm _____
Empire Company _____
 NORTH

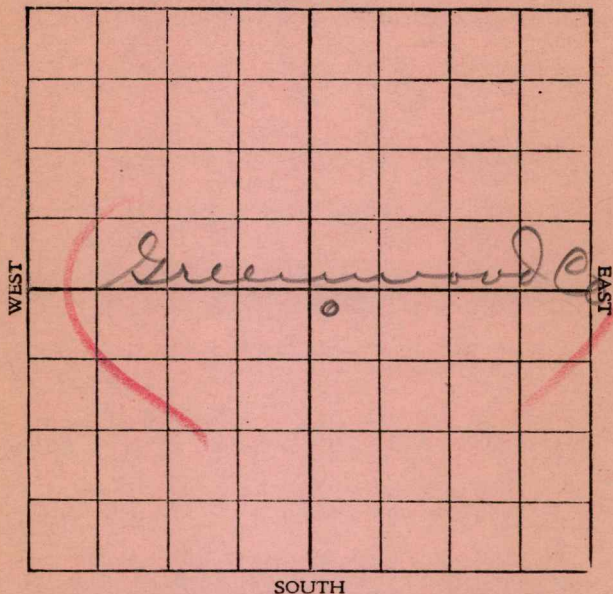

SOUTH

Location _____

Rig up _____

Drilling and remarks:

1025

RECORD

Cased _____ in. _____ Ft.

Sand _____

Gas _____

Oil _____

Total Depth _____

PRODUCTION

1st 24 hrs. Nat. _____

1st 24 hrs. after shot _____

Gas _____ Cu. Ft.

Dry Hole _____

Abandoned _____

Date


11/7, 1917, Carley Scout

Map No. _____ Sec. 25 Twp. 27 R. 8 E

Well No. 1 K. Ford Farm _____
Engine Company _____

NORTH

WEST

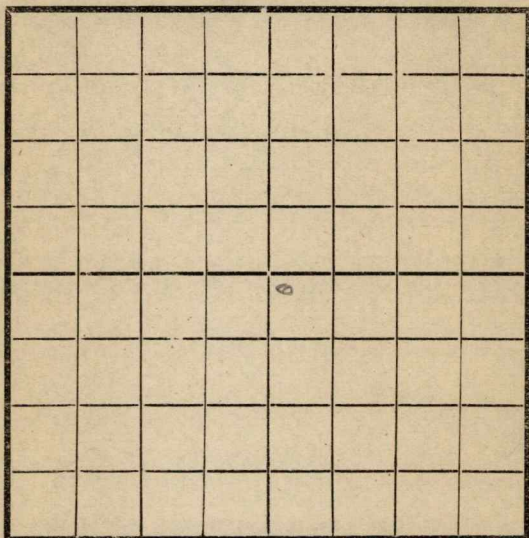

EAST

SOUTH

Location _____
 Rig Up _____
 Drilling and remarks _____

LD 1025

RECORD

Cased _____ in. _____ Ft.
 Sand _____
 Gas _____
 Oil _____
 Total Depth _____

PRODUCTION

1st 24 hrs. Nat. _____
 1st 24 hrs. after shot _____
 Gas _____ Cu. Ft.
 Dry Hole _____
 Abandoned _____

Greenwood


Date

11-14, 1917 Cardiff Scout

Map No. _____ Sec. 25 Twp. 27 R. 8
 Well No. 1 Toford Farm _____
Engine Company _____

NORTH

WEST

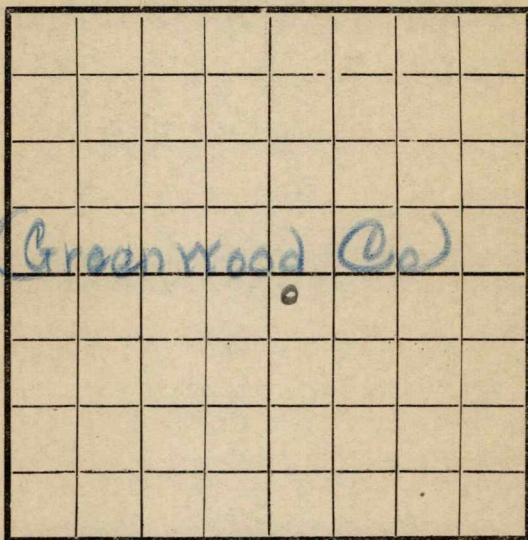

EAST

SOUTH

RECORD

Location _____

Cased _____ in. _____ Ft.

Rig Up _____

Sand _____

Drilling and remarks

Gas _____

Oil _____

Total Depth _____

PRODUCTION

1st 24 hrs. Nat. _____

1st 24 hrs. after shot _____

Gas _____ Cu. Ft.

Dry Hole _____

Abandoned _____


Date

11/21, 1917 Cordery Scout

Map No. _____ Sec. 20 Twp. 27 R. 8Well No. 1 Rafoid FarmEmpire Company

NORTH

WEST

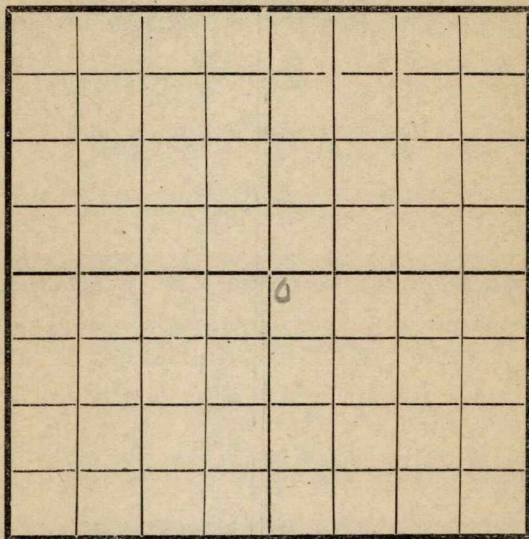

EAST

SOUTH

Location _____

Rig Up _____

Drilling and remarks

1200'

RECORD

Cased _____ in _____ Ft.

Sand _____

Gas _____

Oil _____

Total Depth _____

PRODUCTION

1st 24 hrs. Nat. _____

1st 24 hrs. after shot _____

Gas _____ Cu. Ft.

Dry Hole _____

Abandoned _____

Date


11/29, 1917 Chyle Scout

Map No. _____ Sec. 25 Twp. 27 R. 8Well No. 1 Rapid _____ FarmEmpire _____ Company

NORTH

WEST

EAST

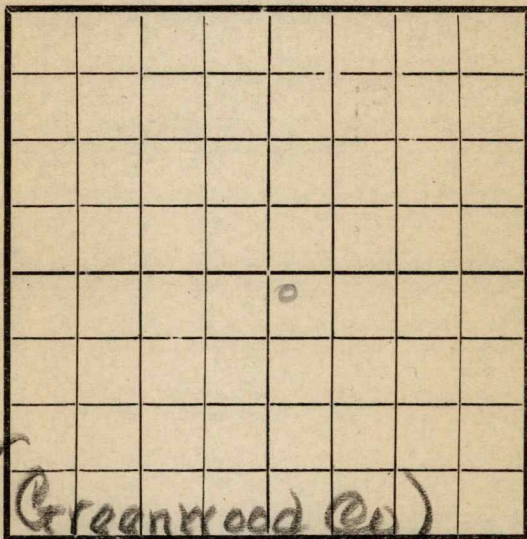

SOUTH

Location _____

Rig Up _____

Drilling and remarks

1080'

RECORD

Cased _____ in. _____ Ft.

Sand _____

Gas _____

Oil _____

Total Depth _____

PRODUCTION

1st 24 hrs. Nat. _____

1st 24 hrs. after shot _____

Gas _____ Cu. Ft.

Dry Hole _____

Abandoned _____

Date


11/281917Cordiff

Scout

Map No. _____ Sec. 25 Twp. 27 R. 8
 Well No. 1 Kofair Farm _____
Empire Company _____

NORTH

WEST

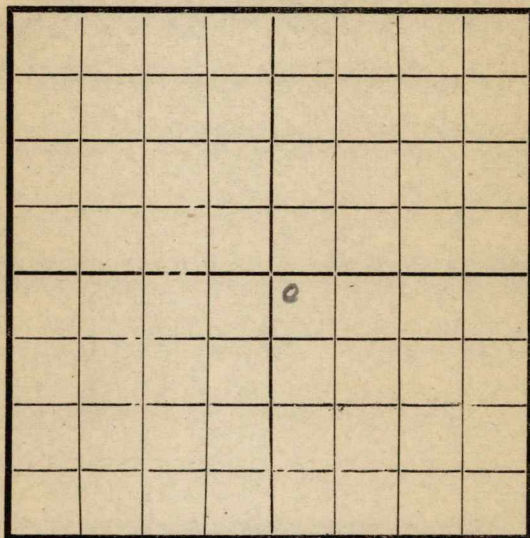

EAST

SOUTH

Location _____

Rig Up _____

Drilling and remarks

1095

RECORD

Cased _____ in. _____ Ft.

Sand _____

Gas _____

Oil _____

Total Depth _____

PRODUCTION

1st 24 hrs. Nat. _____

1st 24 hrs. after shot _____

Gas _____ Cu. Ft.

Dry Hole _____

Abandoned _____


Date

12/5, 1917 Candif Scout

Map No. _____ Sec. 25 Twp. 27 R. 8
 Well No. 1 Haystack Farm _____
Empire & F Company _____

NORTH

WEST

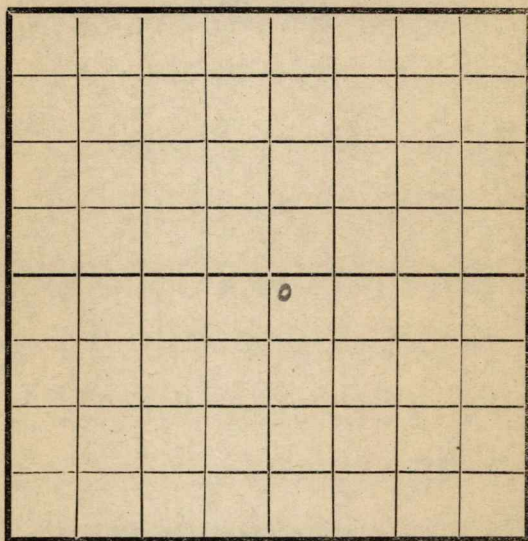

EAST

SOUTH

Location _____

Rig Up _____

Drilling and remarks

1130

RECORD

Cased _____ in. _____ Ft.

Sand _____

Gas _____

Oil _____

Total Depth _____

PRODUCTION

1st 24 hrs. Nat. _____

1st 24 hrs. after shot _____

Gas _____ Cu. Ft.

Dry Hole _____

Abandoned _____

Date

12/12, 1917 Candry Scout


Map No. _____ Sec. 25 Twp. 27 R. 8

Well No. 1 Kofoid Farm _____

Empire Company _____

NORTH

WEST

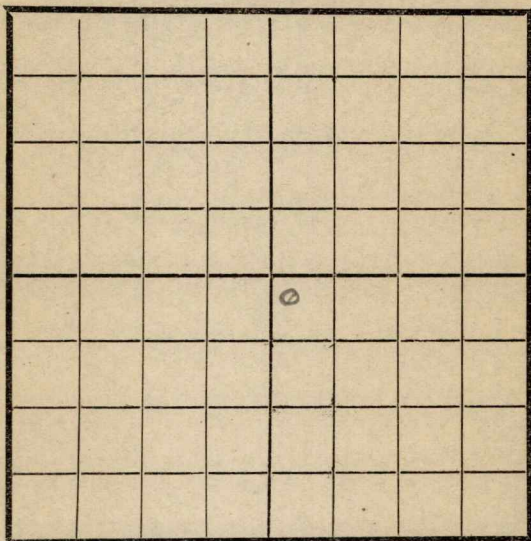

EAST

SOUTH

Location _____

Rig Up _____

Drilling and remarks

RECORD

Cased _____ in _____ Ft.

Sand _____

Gas _____

Oil _____

Total Depth _____

PRODUCTION

1st 24 hrs. Nat. _____

1st 24 hrs. after shot _____

Gas _____ Cu. Ft.

Dry Hole _____

Abandoned _____

Date


10/19, 1917 Condit Scout

1180
Here 1000000
cuft gas

Map No. _____ Sec. 25 Twp. 27 R. 8Well No. 1 Koyaid Farm _____
Empire Company

NORTH

WEST

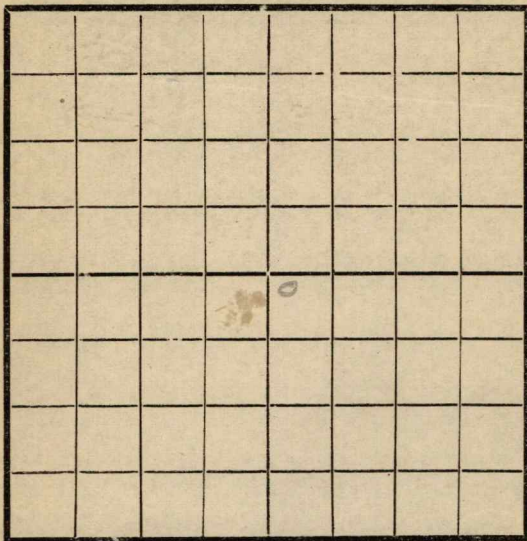

EAST

SOUTH

Location _____

Rig Up _____

Drilling and remarks

1270

RECORD

Cased _____ in. _____ Ft.

Sand _____

Gas _____

Oil _____

Total Depth _____

PRODUCTION

1st 24 hrs. Nat. _____

1st 24 hrs. after shot _____

Gas _____ Cu. Ft.

Dry Hole _____

Abandoned _____

Date

12/28, 1917 Cordiff Scout

Map No. _____ Sec. 25 Twp. 27 R. 8Well No. 1 Kopoid Farm _____Engine Company _____

NORTH

WEST

EAST

SOUTH

Location _____

Rig Up _____

Drilling and remarks

LD 1270'

RECORD

Cased _____ in. _____ Ft.

Sand _____

Gas _____

Oil _____

Total Depth _____

PRODUCTION

1st 24 hrs. Nat. _____

1st 24 hrs. after shot _____

Gas _____ Cu. Ft.

Dry Hole _____

Abandoned _____


Date

1/2, 1918, Co Condyff ScoutGreenwood

Map No. _____ Sec. 25 Twp. 27 R. 8Well No. 1 Kofoid Farm _____
Esquire Company _____

NORTH

WEST

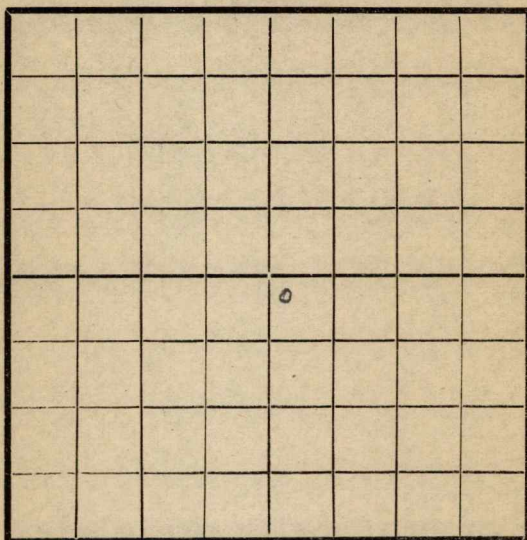

EAST

SOUTH

RECORD

Location _____

Cased _____ in. _____ Ft.

Rig Up _____

Sand _____

Drilling and remarks

Gas _____

Oil _____

Total Depth _____

PRODUCTION

1st 24 hrs. Nat. _____

1st 24 hrs. after shot _____

Gas _____ Cu. Ft.

Dry Hole _____

Abandoned _____


Date

4/16, 1918 Candy Scout

Map No. _____ Sec. 25 Twp. 27 R. 8Well No. 1 K. Laid Farm _____
Empire Company

NORTH

WEST

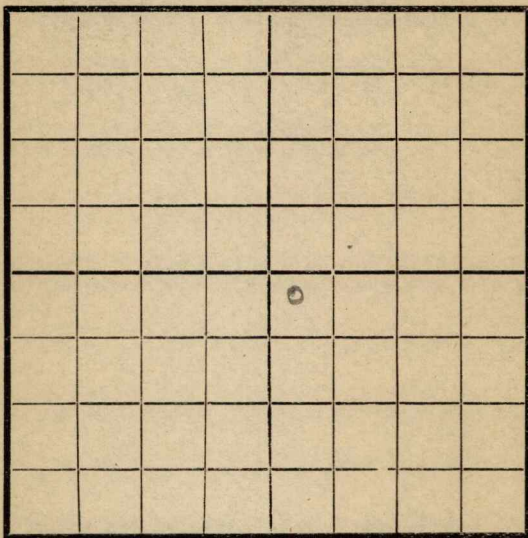

EAST

SOUTH

Location _____

Rig Up _____

Drilling and remarks

22 1270

RECORD

Cased _____ in. _____ Ft.

Sand _____

Gas _____

Oil _____

Total Depth _____

PRODUCTION

1st 24 hrs. Nat. _____

1st 24 hrs. after shot _____

Gas _____ Cu. Ft.

Dry Hole _____

Abandoned _____


Date

1/23, 1918 Cand Scout

Map No. _____ Sec. 25 Twp 27 R. 8
 Well No. 1 Kofoid Farm _____
Engine Company _____

NORTH

WEST

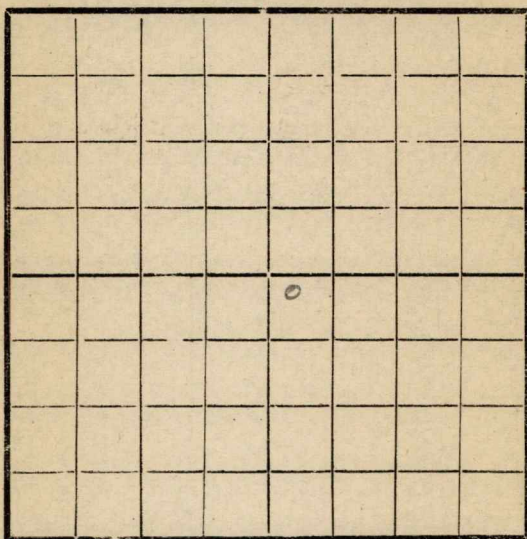

EAST

SOUTH

Location _____
 Rig Up _____
 Drilling and remarks _____

22 1270

RECORD

Cased _____ in _____ Ft.
 Sand _____
 Gas _____
 Oil _____
 Total Depth _____

PRODUCTION

1st 24 hrs. Nat. _____
 1st 24 hrs. after shot _____
 Gas _____ Cu. Ft.
 Dry Hole _____
 Abandoned _____

Date

1/30, 1918 Condy Scout

Map No. _____ Sec. 25 Twp. 27 R. 8


Well No. 1 Kogal Farm _____

_____ Company

NORTH

WEST

EAST

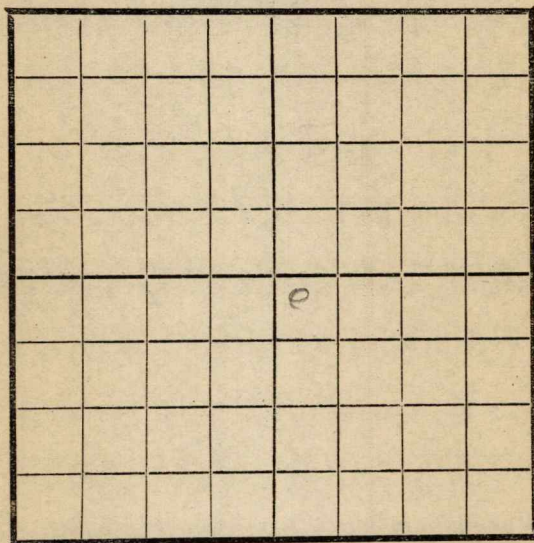

SOUTH

Location _____

Rig Up _____

Drilling and remarks

RECORD

Cased _____ in. _____ Ft.

Sand _____

Gas _____

Oil _____

Total Depth _____

PRODUCTION

1st 24 hrs. Nat. _____

1st 24 hrs. after shot _____

Gas _____ Cu. Ft.

Dry Hole _____

Abandoned _____


Date

2/6, 1918 Conley Scout

Map No. _____ Sec. 25 Twp. 27 R. 8Well No. 1 K. J. J. J. Farm _____Empire Company _____

NORTH

WEST

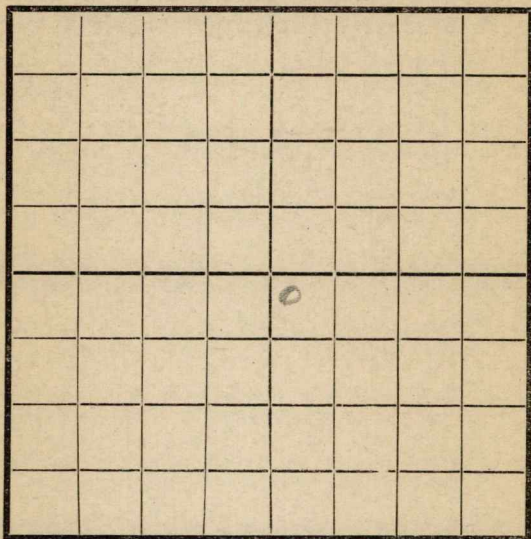

EAST

SOUTH

Location _____

Rig Up _____

Drilling and remarks

RECORD

Cased _____ in. _____ Ft.

Sand _____

Gas _____

Oil _____

Total Depth _____

PRODUCTION

1st 24 hrs. Nat. _____

1st 24 hrs. after shot _____

Gas _____ Cu. Ft.

Dry Hole _____

Abandoned _____

Date


2/13, 1918 Candiff Scout

Map No. _____ Sec. 25 Twp. 27 R. 8Well No. 1 Kopinski Farm _____

Company _____

NORTH

WEST

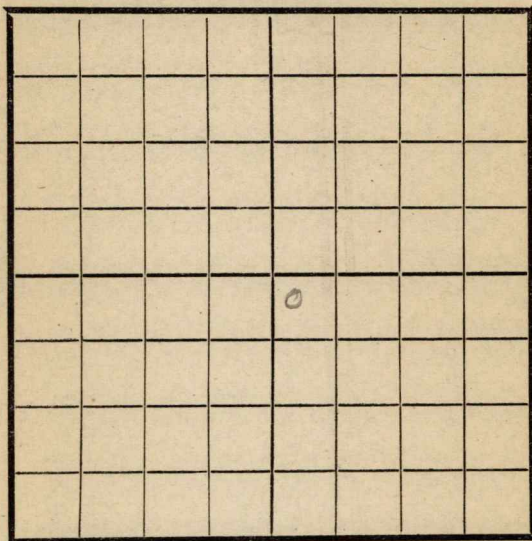

EAST

SOUTH

Location _____

Rig Up _____

Drilling and remarks

1650

RECORD

Cased _____ in. _____ Ft.

Sand _____

Gas _____

Oil _____

Total Depth _____

PRODUCTION

1st 24 hrs. Nat. _____

1st 24 hrs. after shot _____

Gas _____ Cu. Ft.

Dry Hole _____

Abandoned _____


Date

2/27, 1918 Corduff Scout

Map No. _____ Sec. 25 Twp. 27 R. 8Well No. 1 Koford Farm _____Angine Company _____

NORTH

WEST

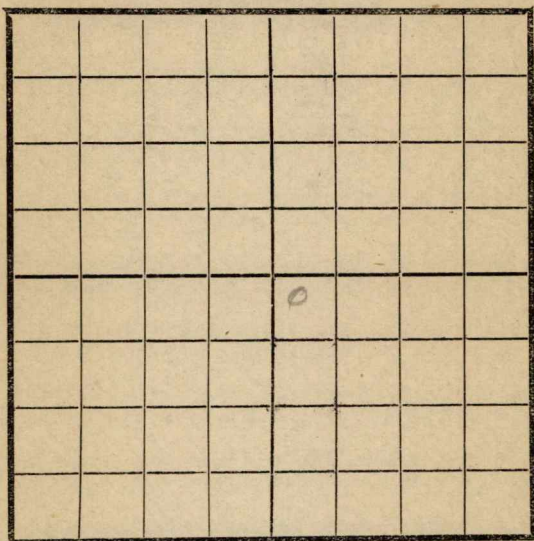

EAST

SOUTH

Location _____

Rig Up _____

Drilling and remarks

1650

RECORD

Cased _____ in _____ Ft.

Sand _____

Gas _____

Oil _____

Total Depth _____

PRODUCTION

1st 24 hrs. Nat. _____

1st 24 hrs. after shot _____

Gas _____ Cu. Ft.

Dry Hole _____

Abandoned _____


Date

3/6, 1918 J. Conley Scout

Map No. _____ Sec. 25 Twp. 27 R. 8Well No. 1 Rogers FarmEmpire Company

NORTH

WEST

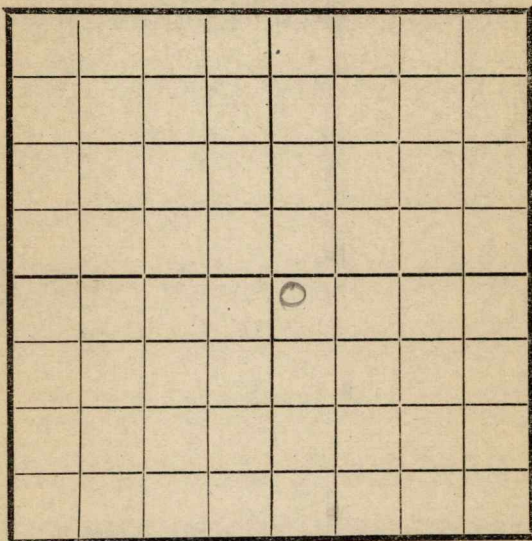

SOUTH

Location _____

Rig Up _____

Drilling and remarks

1680

RECORD

Cased _____ in. _____ Ft.

Sand _____

Gas _____

Oil _____

Total Depth _____

PRODUCTION

1st 24 hrs. Nat. _____

1st 24 hrs. after shot _____

Gas _____ Cu. Ft.

Dry Hole _____

Abandoned _____


Date

3/13, 1918 8 Condry Scout

Map No. _____ Sec. 25 Twp. 27 R. 8Well No. 1775 _____ Farm __________ Calpine _____ Company _____

NORTH

WEST

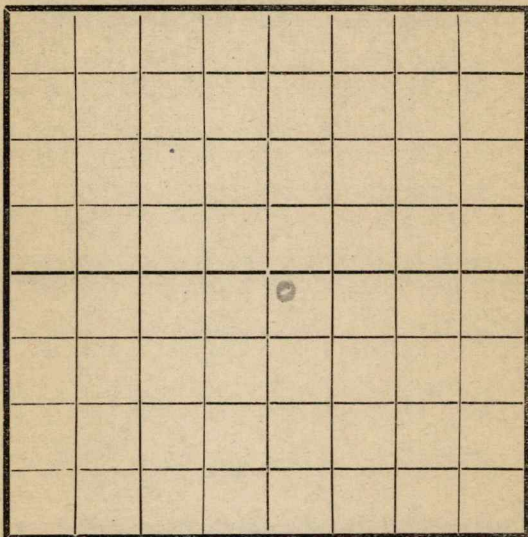

EAST

SOUTH

Location _____

Rig Up _____

Drilling and remarks

1775

Barber & Quinn
Contractors
Augusta

RECORD

Cased _____ in _____ Ft.

Sand _____

Gas _____

Oil _____

Total Depth _____

PRODUCTION

1st 24 hrs. Nat. _____

1st 24 hrs. after shot _____

Gas _____ Cu. Ft.

Dry Hole _____

Abandoned _____

Date


3/20, 1918Calpine

Scout

Map No. _____ Sec. 25 Twp. 27 R. 8Well No. 1 K. R. G. L. Farm _____Company Campine

NORTH

WEST

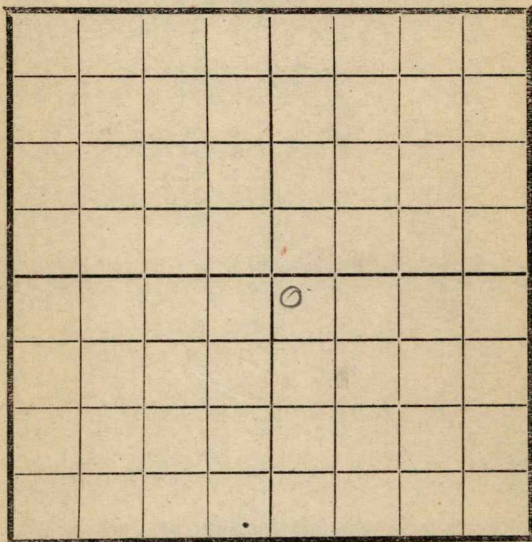

EAST

SOUTH

Location _____

Rig Up _____

Drilling and remarks

got top sand
at about 1790
Has 800' oil in
hole with some
water

RECORD

Cased _____ in. _____ Ft.

Sand _____

Gas _____

Oil _____

Total Depth _____

PRODUCTION

1st 24 hrs. Nat. _____

1st 24 hrs. after shot _____

Gas _____ Cu. Ft.

Dry Hole _____

Abandoned _____


Date

3/23, 1918 C. R. G. L. Scout

Map No. K 10 Sec. 25 Twp. 27 R. 8Well No. 1 Kofail Farm
Empire Company

NORTH

WEST

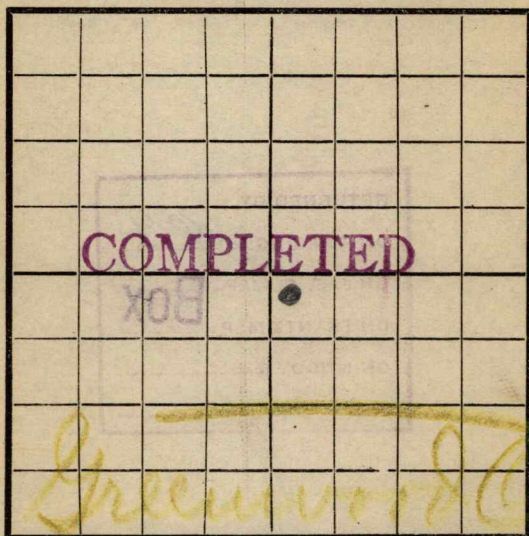

EAST

SOUTH

Location -----

Rig Up -----

Drilling and remarks

Has 1600 ft
oil & 1000000
cu ft gas -
Probably pump
25 Bbls oil

RECORD

Cased ----- in. ----- Ft.

Sand 1795-1837

Gas -----

Oil -----

Total Depth -----

PRODUCTION

1st 24 hrs. Nat. -----

1st 24 hrs. after shot -----

Gas ----- Cu. Ft.

Dry Hole -----

Abandoned -----

Date

3/27, 1918 Scout