


Map No. 75 Sec. 18 Twp. 32 R. 3E

Well No. 1- Durin Farm \_\_\_\_\_

Bryan Ed Stinson Company

NORTH

LOG

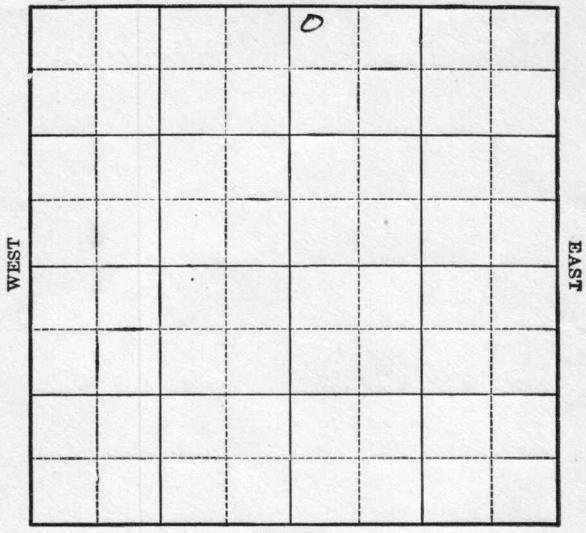

Location \_\_\_\_\_

Drilling Remarks:

---

---

Rig Up \_\_\_\_\_

Drilling Remarks:

---

---

RECORD

Cased \_\_\_\_\_ in. \_\_\_\_\_ ft.  
 Sand \_\_\_\_\_  
 Gas \_\_\_\_\_  
 Oil \_\_\_\_\_  
 Total Depth \_\_\_\_\_


PRODUCTION

1st 24 hrs. Nat. \_\_\_\_\_  
 1st 24 hrs. after shot \_\_\_\_\_  
 Gas \_\_\_\_\_ cu. ft.  
 Dry Hole \_\_\_\_\_  
 Abandoned \_\_\_\_\_

Map No. K Sec. 18 Twp. 32 R. 3

Well No. 1 Orin Farm  
Bryan E. Stinson Company

200 Ft. from N. Line  
 \_\_\_\_\_ Ft. from S. Line  
 \_\_\_\_\_ Ft. from E. Line  
200 Ft. from W. Line

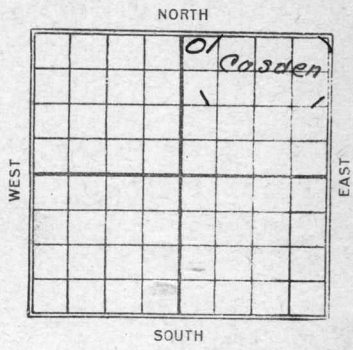

Date	REPORT
<u>1924</u>	
<u>3/14</u>	<u>Location</u>
<u>4/24</u>	<u>Rig Bldg</u>
<u>6/18</u>	<u>Blg @ 1775'</u>
<u>25</u>	<u>" @ 1850</u>
<u>7/9</u>	<u>UB 9 1/4 to 2375</u>
<u>7/16</u>	<u>show 2606 - 36 D. 2645'</u>
<u>7/31</u>	<u>3124 - 38 Small Sho</u> <u>Top Line 3156' (Tel)</u>
<u>8/1</u>	<u>Blg 3200' Got Top</u> <u>Line 3156' (Tel)</u>
<u>8/20</u>	<u>(Telegram)</u> <u>Thin Wilcox sand</u> <u>3507 - <del>HR</del></u>
<u>9/9</u>	<u>Wilcox 3497 - 3502</u> <u>Red 3507</u>

Map No. **KANSAS** Sec. 18 Twp. 32 R. 38

Well No. #1 Quinn

Bryan & Shison Company

Contractor

**FIRST REPORT**

**SECTION PLAT**

200 Ft. from N. Line

----- Ft. from S. Line

----- Ft. from E. Line

200 Ft. from W. Line

		0	

Location ✓✓

Rig up -----

Drilling and Remarks:

**RECORD**

Cased ----- in., ----- ft.

Sand -----

Gas -----

Oil -----

Total Depth -----

**PRODUCTION**

1st 24 hrs. Nat. -----

1st 24 hrs. after shot -----

Gas ----- Cu. Ft.

Dry Hole -----

Abandoned -----

Date

MAR 14 1924

M. A. BENEAR

192

Scout

171 **KANSAS** Sec. 18 Twp. 32 R. 38

Well No. 1 - Dunn

Bryan & Stinson Company

Contractor

# ABANDONED SECTION PLAT

200 Ft. from N. Line

\_\_\_\_\_ Ft. from S. Line

\_\_\_\_\_ Ft. from E. Line

200 Ft. from W. Line

		Strip 0	CO 29

Location \_\_\_\_\_

Rig up \_\_\_\_\_

Drilling and Remarks:

*Wilson No. 3497-  
3502  
1049  
3507*

## RECORD

Cased \_\_\_\_\_ in., \_\_\_\_\_ ft.

Sand \_\_\_\_\_

Gas \_\_\_\_\_

Oil \_\_\_\_\_

Total Depth \_\_\_\_\_

## PRODUCTION

1st 24 hrs. Nat. \_\_\_\_\_

1st 24 hrs. after shot \_\_\_\_\_

Gas \_\_\_\_\_ Cu. Ft.

Dry Hole \_\_\_\_\_

Abandoned \_\_\_\_\_

Date

SEP 9 1924

M. A. BENEAR

192

Scout

*Run through with  
next barrel*

Map No. \_\_\_\_\_  
Twp. \_\_\_\_\_  
R. \_\_\_\_\_

This is wrong location  
please check and advise  
correct location

On Cosden acreage.


ft. from N. line  
ft. from S. line  
ft. from E. line  
ft. from W. line

Location  
Dig up  
Drilling and Remarks:  
Oil  
Gas  
Sand  
Case

- Returned
- Cards
- Tracing
- J. S. C. map
- Gast map
- Moody map
- Gast plat book
- Moody plat book

Date

MAP No. \_\_\_\_\_ SEC. 18 TWP. 32S R. 3E

WELL No. 1 Dunn  
Bryant + Steison COMPANY

CONTRACTOR

**SECTION PLAT**

		0	

\_\_\_\_\_ FT. FROM N. LINE  
 \_\_\_\_\_ FT. FROM S. LINE  
 \_\_\_\_\_ FT. FROM E. LINE  
 \_\_\_\_\_ FT. FROM W. LINE

*et.*

**RECORD**

LOCATION \_\_\_\_\_  
 RIG UP \_\_\_\_\_

CASED \_\_\_\_\_ IN. \_\_\_\_\_ FT.  
 SAND \_\_\_\_\_  
 GAS \_\_\_\_\_  
 OIL \_\_\_\_\_  
 TOTAL DEPTH 3507

DRILLING AND REMARKS:

**PRODUCTION**

1ST 24 HRS. NAT. \_\_\_\_\_  
 1ST 24 HRS. AFTER SHOT \_\_\_\_\_  
 GAS \_\_\_\_\_ CU. FT.  
 DRY HOLE   
 ABANDONED

DATE

8/30 \_\_\_\_\_ 1924 \_\_\_\_\_ SCOUT