


Section 12 Township 32 Range 3E

Well No. 1 Kittleson

Company Tom Palmer

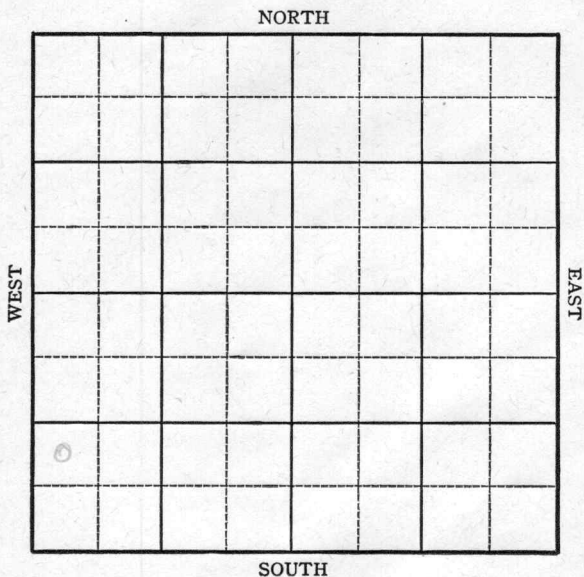

Sec. 12 Twp. 32 R. 3-E

Well No. #1 Kittleson Farm


Tom Palmer Company

\_\_\_\_\_ Ft. from N. Line

990 Ft. from S. Line

\_\_\_\_\_ Ft. from E. Line

330 Ft. from W. Line

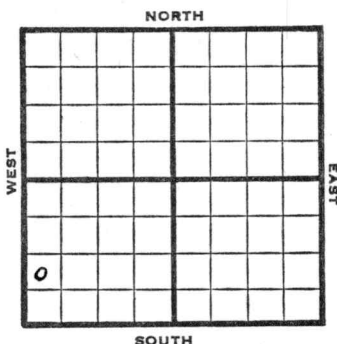

NW SW SW

REPORT

1945 Elev. 1204

9/12 Cable

9/19 Rig

9/26 15" @ 448

Drlg. 590

10/3 1325 S.D. for csg.

10/10 13" @ 1335

Drlg. 1635

10/17 10" @ 1793

Drlg. 2105

10/24 2351 Run 8"

10/31 8" @ 2357

Drlg. 2660'

11/7 Miss. 3120

Drlg. 3130'

11/14 Arb. 3414

TD 3435'

ABANDONED



