

# KANSAS

Form 51-5M-7-39-Palace

## Cowley


Section 14 Township 32 Range 3-E

Well No. #1-A Ehmke (*Ehmke*)

Company R. M. Stewart et al

NORTH

Carson Pool

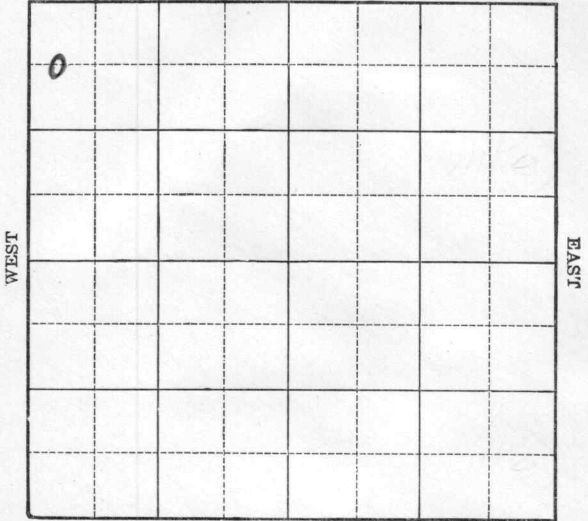

SOUTH

WEST

EAST

Sec. 14 Twp. 32 R. 3-E

Well No. #1-A Emhke Farm

R. M. Stewart et al Company

(Carson)


660 Ft. from N. Line

\_\_\_\_\_ Ft. from S. Line

\_\_\_\_\_ Ft. from E. Line

330 Ft. from W. Line

Elev. 1218 Est DF  
1215 GR

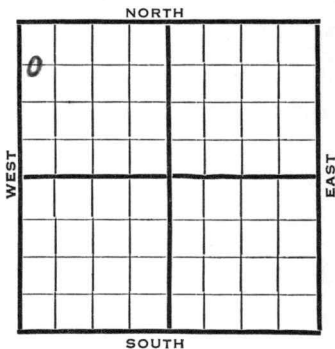

1940	REPORT
4/17	Cellar.
4/25	"
5/2	"
5/9	"
5/16	"
5/23	Rigging up.
5/29	20" - 46' 15" - 421' Drlg. 438'
6/6	1340' run 12".
6/13	1880' run 10".
6/20	10" - 1886' 1950' U.R. 10".
6/27	Stalnaker 2135' 8" - 2235' Drlg. 2640'
7/3	6" - 2717' Drlg. 2910'
7/10	Arb. 3451' T.D. 3460' Water.
	ABANDONED

Map No. / Sec. 14 Twp. 32 R. 3E

Well No. 1-A Emhke

R. M. Stewart etal Company

FIRST REPORT Contractor

C W L NW NW

660 Ft. from N. Line

Ft. from S. Line

Ft. from E. Line

330 Ft. from W. Line

CARSON POOL

## SECTION PLAT


Location \_\_\_\_\_

Rig up \_\_\_\_\_

Drilling and Remarks:

Cellar

## RECORD

Cased \_\_\_\_\_ in., \_\_\_\_\_ ft.

Sand \_\_\_\_\_

Gas \_\_\_\_\_

Oil \_\_\_\_\_

Total Depth \_\_\_\_\_

## PRODUCTION

1st 24 hrs. Nat. \_\_\_\_\_

1st 24 hrs. after shot \_\_\_\_\_

Gas \_\_\_\_\_ Cu. Ft.

Dry Hole \_\_\_\_\_

Abandoned \_\_\_\_\_

Date

APR 17 1940 19

S. J. LEWIS Scout

Map No.      /      Sec. 14 Twp. 32 R. 3E

Well No. 1-A Emhke

R. N. Stewart Company

Contractor

ABANDONED

SECTION PLAT

660 C W L NW NW  
Ft. from N. Line

\_\_\_\_\_ Ft. from S. Line

\_\_\_\_\_ Ft. from E. Line

330 Ft. from W. Line

o			

CARSON POOL

Location \_\_\_\_\_

Rig up \_\_\_\_\_

Drilling and Remarks:

*Oil & 3451*

*Water.*

RECORD

Cased \_\_\_\_\_ in., \_\_\_\_\_ ft.

Sand \_\_\_\_\_

Gas \_\_\_\_\_

Oil \_\_\_\_\_

Total Depth 3460

PRODUCTION

1st 24 hrs. Nat. \_\_\_\_\_

1st 24 hrs. after shot \_\_\_\_\_

Gas      /      Cu. Ft.

Dry Hole \_\_\_\_\_

Abandoned \_\_\_\_\_

Date

JUL 10 1940 19

S. J. LEWIS Scout