


Section 25 Township 27 Range 8-E

Well No. 1 Lewis


Company Weideman et al

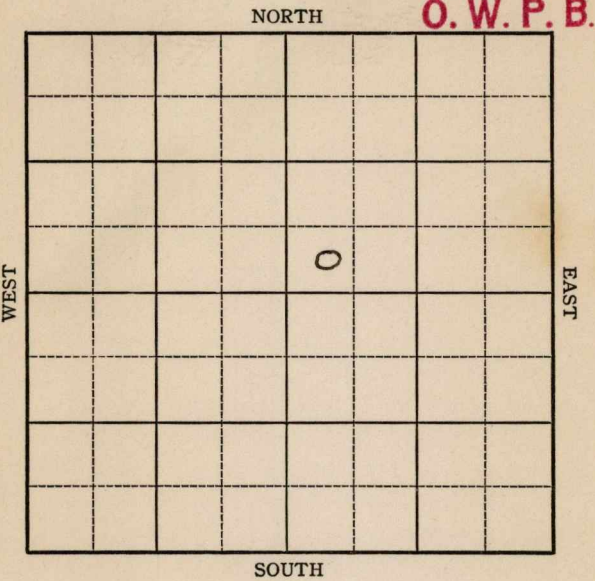

Sec. 25 Twp. 27 R. 8-EWell No. #1 Lewis (Twin) FarmWeideman et al

Company

NORTH

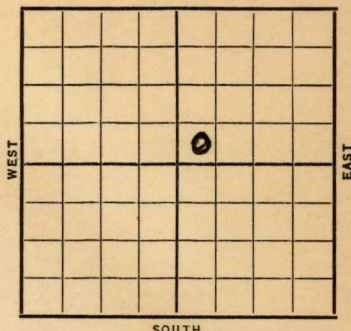

SOUTH

 Ft. from N. Line330 Ft. from S. Line Ft. from E. Line450 Ft. from W. Line

Date	REPORT O. W. P. B.
1937	
11/3	Cellar.
11/26	"
12/3	Drlg. 320'.
12/10	12" @ 421'. Drlg. 610'.
12/17	10" @ 896'. Drlg. 970'.
12/24	" " " " "
12/31	SD @ 1150'.
1938	
1/7	" "
1/14	" "
1/20	" "
1/28	" "
2/4	Rigging up to start again TD 1150'
2/11	" " " " "
2/18	" " " " "
2/26	" " " " "
3/4	T.D. 1400'. U. R. 8".
3/11	8" @ 1200'. Drlg. 1450'.
3/18	Drlg. 1625'.
3/25	TD 1625' SD.

OVER

1938

4/1 T.D. 1840' SD.

4/8 TD 1840' SD.

4/15 6" @ 1788'. Peru 1824-87'.

10 qts. Shot. 400' oil.

Drlg. 1888'.

4/22 " "

4/29 TD 1900' SD.

5/6 " "

5/12 " "

5/20 T.D. 2004'. P.B. 1834'.

Shot 20 qts. Est. 10 oil &
25 wtr. per day..

Installing pump.

5/27 " " "

6/3 " " "

6/8 6" @ 1788'.

Peru 1824'.

T.D. 2004'.

P. B. 1834'.

Shot 20 qts.

Potential 12 oil & 20 water.

COMPLETED

O. W. P. B.

1939

6/7---OTD 2004 PB 1834 TD 2428

Miss. 2420 5" 2420

1000 acid

Pump 30 bbls. oil

FIRST REPORT

COMPLETED

Map No. 10 Sec. 25 Twp. 27 R. 8EWell No. 1 Lewis (TWIN)Weideman etal Company

Contractor

FIRST REPORT

SECTION PLAT

SW NE

 Ft. from N. Line330 Ft. from S. Line Ft. from E. Line450 Ft. from W. Line

		0	

Location Rig up

Drilling and Remarks:

Cellar

RECORD

Cased in., ft.Sand Gas Oil Total Depth

PRODUCTION

1st 24 hrs. Nat. 1st 24 hrs. after shot Gas Cu. Ft.Dry Hole Abandoned

Date

NOV 3 1937 19

H. D. Hatfield

Scout

Greenwood **KANSAS**Map No. 10 Sec. 25 Twp. 27 R. 8EWell No. 1 Lewis (Twin)Weideman etal

Company

Contractor

COMPLETED**SW NE** Ft. from N. Line330 Ft. from S. Line Ft. from E. Line450 Ft. from W. Line**SECTION PLAT**

		0	

Location Rig up

Drilling and Remarks:

PB1834Shot 20 gtsPOT 12 oil20 wtr**RECORD**Cased 6 in., 1788 ft.Sand Peru 1824Gas Oil Total Depth 2004**PRODUCTION**1st 24 hrs. Nat. 1st 24 hrs. after shot Gas Cu. Ft.Dry Hole Abandoned

Date

JUN 8 - 1938

19

H. D. Hatfield

Scout

Greenwood

Map No. 10 Sec. 25 Twp. 27 R. 8EWell No. 1 Lewis

K. T. Wieman

Company

FIRST REPORT

Contractor

&

COMPLETED

SECTION PLAT

SW NE

Ft. from N. Line

330

Ft. from S. Line

Ft. from E. Line

450

Ft. from W. Line

		0	

BEAUMONT POOL

Location _____

Rig up _____

Drilling and Remarks:

OW 111

Old TD 2004

P.B 1834

Hiss 2420

5" e 2420

1000 acid

Pump 30 ft hole

RECORD

Cased _____ in., _____ ft.

Sand _____

Gas _____

Oil _____

Total Depth 2428

PRODUCTION

1st 24 hrs. Nat. _____

1st 24 hrs. after shot _____

Gas _____ Cu. Ft.

Dry Hole _____

Abandoned _____

Date

JUN 7 1939

19

S. J. LEWIS

Scout