

NORTH

WEST

EAST

SOUTH

Location -----

Drilling Remarks:

RECORD

Cased----- in.----- ft.

Sand _____

Gas _____

Oil-----

Total Depth -----

Rig Up -----

Drilling Remarks:

PRODUCTION

1st 24 hrs. Nat.-----

1st 24 hrs. after shot-----

Gas ----- cu. ft.

Dry Hole -----

Abandoned -----

Map No. 110 Sec. 25 Twp. 27 R. 8Well No. 3 G R. LewisEmpire Company

Contractor

NORTH

WEST

EAST

*This ticket is correct
Empire & Thicket Nat
are all the same*

SOUTH

264 N + E

Location _____

Rig up ☒

Drilling and Remarks:

RECORD

Cased _____ in., _____ ft.

Sand _____

Gas _____

Oil _____

Total Depth _____

PRODUCTION

1st 24 hrs. Nat. _____

1st 24 hrs. after shot _____

Gas _____ Cu. Ft.

Dry Hole _____

Abandoned _____

FIRST REPORT


Date

1/23 1919 Conley Scout

Map No. K10 Sec. 24 Twp. 27 R. 8Well No. St. L. Lewis

Company _____

Contractor _____

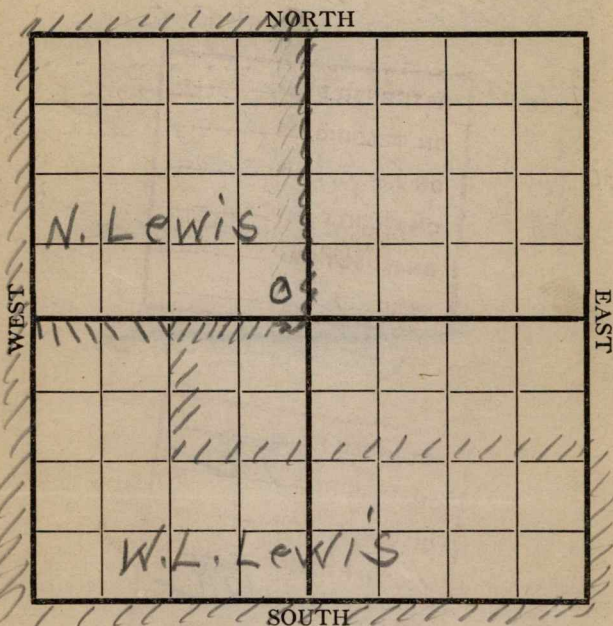

Location _____

Rig up _____

Drilling and Remarks:

RECORD

Cased _____ in., _____ ft.

Sand _____

Gas _____

Oil _____

Total Depth _____

PRODUCTION

1st 24 hrs. Nat. _____

1st 24 hrs. after shot _____

Gas _____ Cu. Ft.

Dry Hole _____


Abandoned _____

Date

Feb 7 1919 Pyle Scout

Map No. X10 Sec. 25 Twp. 27 R. 8Well No. St. L. LewisEmpire Company

Contractor

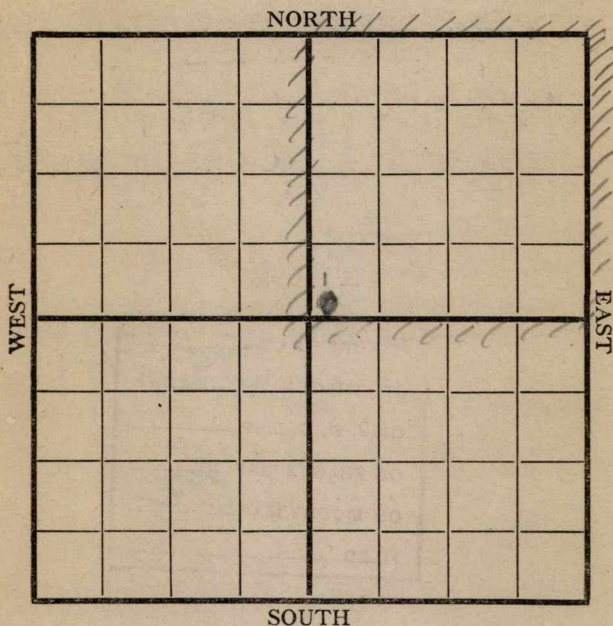

Location _____

Rig up _____

Drilling and Remarks:

This ticket is correct

RECORD

Cased _____ in., _____ ft.

Sand _____

Gas _____

Oil _____

Total Depth _____

PRODUCTION

1st 24 hrs. Nat. _____

1st 24 hrs. after shot _____

Gas _____ Cu. Ft.

Dry Hole _____

Abandoned _____

Date

Feb 7 1919 Cyle Scout


Map No. K10 Sec. 24 Twp. 27 R. 8Well No. Hannie LewisCompany Empire

Contractor _____

NORTH

WEST

EAST

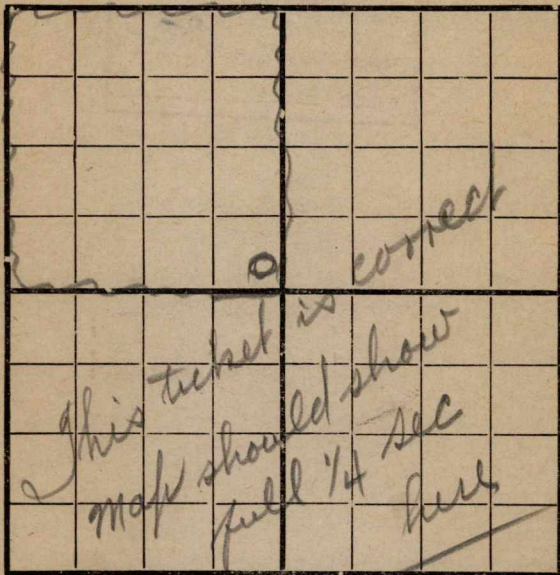

SOUTH

Location _____

Rig up _____

Drilling and Remarks:

RECORD

Cased _____ in., _____ ft.

Sand _____

Gas _____

Oil _____

Total Depth _____

PRODUCTION

1st 24 hrs. Nat. _____

1st 24 hrs. after shot _____

Gas _____ Cu. Ft.

Dry Hole _____

Abandoned _____

Date

Feb 7 1919 Cy h Scout