


Greenwood
Form 51-5M-2-29-34703

Map No. **KANSAS** Sec. 25 Twp. 27 R. 8E
Well No. 1- Lewis Farm
Thomas & Henderson Company

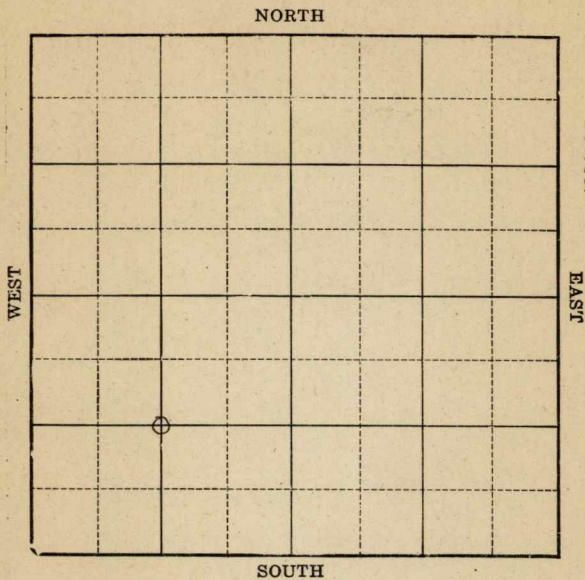

Location _____
Drilling Remarks _____

Rig Up _____
Drilling Remarks _____

RECORD

Cased _____ in. _____ ft.
Sand _____
Gas _____
Oil _____
Total Depth _____

PRODUCTION


1st 24 hrs. Nat. _____
1st 24 hrs. after shot _____
Gas _____ cu. ft. _____
Dry Hole _____
Abandoned _____

Map No. **KANSAS** Sec. 25 Twp. 27 R. 8E

Well No. 1 - Lewis Farm

Thomas & Henderson Company

NORTH

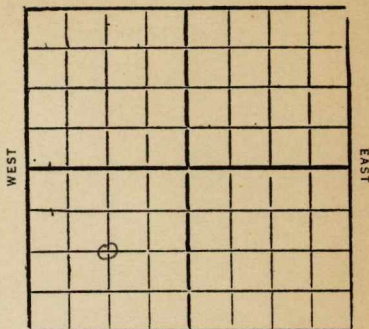

Ft. from N. Line

1320 Ft. from S. Line

Ft. from E. Line

1320 Ft. from W. Line

1931

SOUTH

Date

REPORT

9/30 Drlg 680'
10/7
10/14 Drlg 1100'
10/21 Top sand 1104
show gas 1110
drlg 1118
10/28
11/4 Sand 1104-38
TD 1138
360,000 cu ft gas
Comp.

10

Greenwood

Map No. **KANSAS** Sec. 25 Twp. 27 R. 8 E

Well No. 1 Lewis

Thomas & Henderson Company

Contractor

FIRST REPORTS

SECTION PLAT

.....Ft. from N. Line

1320 Ft. from S. Line

.....Ft. from E. Line

1320 Ft. from W. Line

Location.....

Rig up.....

Drilling and Remarks:

leg 680

RECORD

Cased.....in.,ft.

Sand.....

Gas.....

Oil.....

Total Depth.....

PRODUCTION

1st 24 hrs. Nat.....

1st 24 hrs. after shot.....

Gas.....Cu. Ft.

Dry Hole.....

Abandoned.....

Date

SEP 30 1931 192 **CHAS. L. SHERWOOD** Scout

Greenwood

10 KANSAS

Map No. Sec. 25 Twp. 27 R. 8^E

Well No. 1 Lewis

Thomas O Henderson Company

Contractor

COMPLETED

SECTION PLAT

	11		
	1		

10 Ft. from N. Line

1320 Ft. from S. Line

Ft. from E. Line

1320 Ft. from W. Line

Location

Rig up

Drilling and Remarks:

RECORD

Cased in, ft.

Sand 1104-1138

Gas

Oil

Total Depth 1138

PRODUCTION

1st 24 hrs. Nat.

1st 24 hrs. after shot

Gas 360,000 Cu. Ft.

Dry Hole

Abandoned

Date

NOV 4 1931

192 CHAS. L. SHERWOOD Scout