


Map No. 25 Sec. 19 Twp. 32 R. 3  
Well No. 1 W J Carson Farm  
JB Slick (Carson) Company

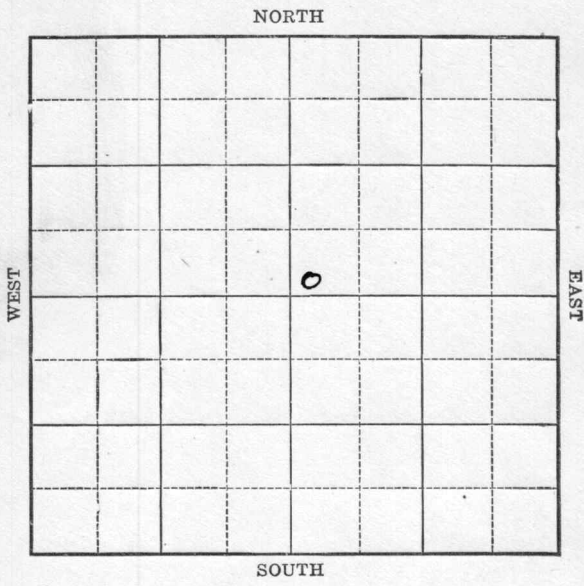

Location \_\_\_\_\_

Drilling Remarks:

\_\_\_\_\_

\_\_\_\_\_

RECORD

Cased \_\_\_\_\_ in. \_\_\_\_\_ ft.

Sand \_\_\_\_\_

Gas \_\_\_\_\_

Oil \_\_\_\_\_

Total Depth \_\_\_\_\_

Rig Up \_\_\_\_\_

Drilling Remarks:

\_\_\_\_\_

\_\_\_\_\_

PRODUCTION

1st 24 hrs. Nat. \_\_\_\_\_

1st 24 hrs. after shot \_\_\_\_\_

Gas \_\_\_\_\_ cu. ft.

Dry Hole \_\_\_\_\_

Abandoned \_\_\_\_\_



KANSAS

Map No. \_\_\_\_\_ Sec. 19 Twp. 32 R. 3Well No. 1 W J CarsonT. B. Glick Company

Contractor

## FIRST REPORT

## SECTION PLAT

\_\_\_\_\_ Ft. from N. Line

200' Ft. from S. Line

\_\_\_\_\_ Ft. from E. Line

200' Ft. from W. Line

|  |  |   |  |
|--|--|---|--|
|  |  |   |  |
|  |  | 0 |  |
|  |  |   |  |
|  |  |   |  |

Location ✓✓

Rig up \_\_\_\_\_

Drilling and Remarks:

## RECORD

Cased \_\_\_\_\_ in., \_\_\_\_\_ ft.

Sand \_\_\_\_\_

Gas \_\_\_\_\_

Oil \_\_\_\_\_

Total Depth \_\_\_\_\_

## PRODUCTION

1st 24 hrs. Nat. \_\_\_\_\_

1st 24 hrs. after shot \_\_\_\_\_

Gas \_\_\_\_\_ Cu. Ft.

Dry Hole \_\_\_\_\_

Abandoned \_\_\_\_\_

Date

APR 23 1924

M. A. BENEAR

192

Scout

Map No. **KANSAS** Sec. 19 Twp. 32 R. 3

Well No. #1 W.G. Cardon  
T.B. Slick Company

Contractor

# COMPLETED SECTION PLAT

\_\_\_\_\_ Ft. from N. Line

200 Ft. from S. Line

\_\_\_\_\_ Ft. from E. Line

200 Ft. from W. Line

|  |  |  |  |
|--|--|--|--|
|  |  |  |  |
|  |  |  |  |
|  |  |  |  |
|  |  |  |  |

Location \_\_\_\_\_

Rig up \_\_\_\_\_

Drilling and Remarks:

*Wilex 3724-32*

*started off 915 ft*

*now making 700 ft*

## RECORD

Cased \_\_\_\_\_ in., \_\_\_\_\_ ft.

Sand \_\_\_\_\_

Gas \_\_\_\_\_

Oil \_\_\_\_\_

Total Depth \_\_\_\_\_

## PRODUCTION

1st 24 hrs. Nat. \_\_\_\_\_

1st 24 hrs. after shot \_\_\_\_\_

Gas \_\_\_\_\_ Cu. Ft.

Dry Hole \_\_\_\_\_

Abandoned \_\_\_\_\_

Date

NOV 12 1924

M. A. BENEAR

192

Scout