

KANSAS

Section 19 Township 32 Range 3-E

Well No. #1 Carson

Company K. T. Weedeman

NORTH

						0	

WEST

EAST

SOUTH

Sec. 19 Twp. 32 R. 3-E

Well No. #1 Carson Farm

K T Weedeman Company

Carson Contractor


990 Ft. from N. Line

\_\_\_\_\_ Ft. from S. Line

990 Ft. from E. Line

\_\_\_\_\_ Ft. from W. Line

SW NE NE

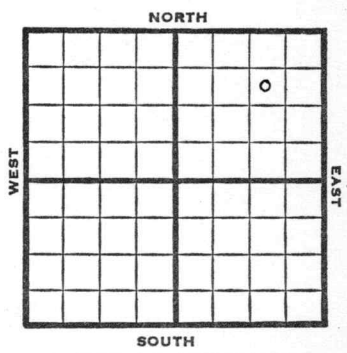

1950 Elev. 1145' REPORT

5/24 Rig Up

9/20 D&A TD 2250'

15" @ 65' 10" @ 1335'

8" @ 1955'

TD 2250'

D&A

**ABANDONED**

Kansas Carson

Map No. \_\_\_\_\_ Sec. 19 Twp. 32 R. 3E

Well No. 1 Carson

K T Weedeman Company

Contractor

SW NE NE

990 Ft. from N. Line

Ft. from S. Line

990 Ft. from E. Line

Ft. from W. Line

SECTION PLAT

			0
FIRST		REPORT	

Cowley

Location \_\_\_\_\_

Rig up X

Drilling and Remarks:

RECORD

Cased \_\_\_\_\_ in., \_\_\_\_\_ ft.

Sand \_\_\_\_\_

Gas \_\_\_\_\_

Oil \_\_\_\_\_

Total Depth \_\_\_\_\_

PRODUCTION

1st 24 hrs. Nat. \_\_\_\_\_

1st 24 hrs. after shot \_\_\_\_\_

Gas \_\_\_\_\_ Cu. Ft.

Dry Hole \_\_\_\_\_

Abandoned \_\_\_\_\_

Date

MAY 24 1950

19

J. E. TYRA

Scout


County Cowley State Kansas

Sec. 19 (Blk. 32) (Sur. 3E) (Twp.) Map No.

Operator K.T. Weidemann

Well No. 1 Farm Carson

Elev. 1145 Location SW NE NE

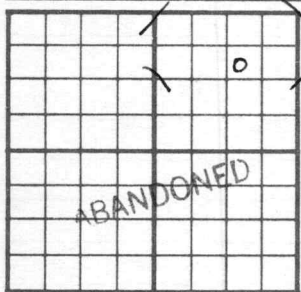

990 Ft. From N Line NE

990 Ft. From E Line Quarter

1st. Report

Completion SEP 20 1950

Remarks

Carson Pool

Spudding Date

Drlg. Data D & A TD 2250

15" @ 65 10" @ 1335 8" @ 1955

TD 2250 D & A