


Map No. 1 Sec 25 Twp. 27 R 8
 Well No. 1 Lewis Farm
Sedwick O & Gas Company

NORTH

WEST

EAST

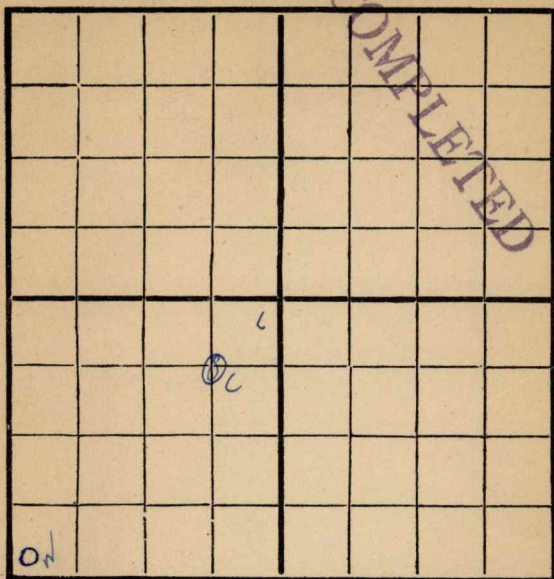

SOUTH

Location _____

Rig Up _____

Drilling Remarks:

Drilling Remarks:

S.D. for rods 12/28

RECORD

Cased _____ in _____ Ft.

Sand _____

Gas _____

Oil _____

Total Depth _____

PRODUCTION

1st 24 hrs. Nat. _____

1st 24 hrs. after shot _____

Gas _____ Cu. Ft.

Dry Hole _____


Abandoned _____

Map No. _____ Sec. 25 Twp. 27 R. 8Well No. 2 Lewis Farm _____Sedwick Oil & Gas Company _____

NORTH

WEST

EAST

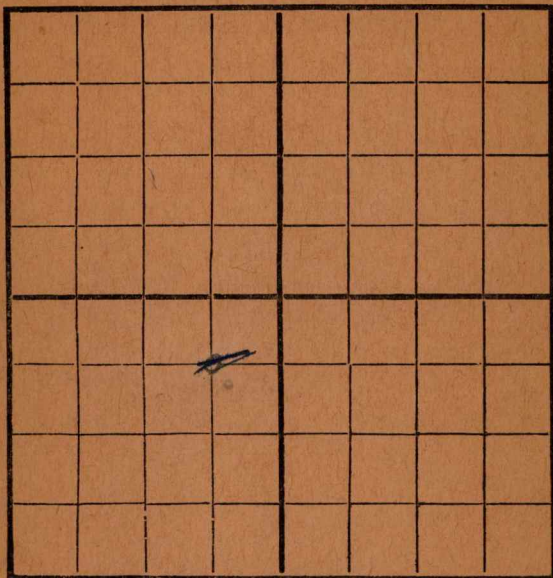

SOUTH

Location _____

Rig Up _____

Drilling and remarks

5/6 133510 m gasfinished 5/5

RECORD

Cased _____ in. _____ Ft.

Sand 1310-1335

Gas _____

Oil _____

Total Depth _____

PRODUCTION

1st 24 hrs. Nat. _____

1st 24 hrs. after shot _____

Gas _____ Cu. Ft.

Dry Hole _____

Abandoned _____

Date

5/61916


Scout

Map No. _____ Sec. 25 Twp. 27 R. 9
 Well No. 1 Lewis Farm _____
Wichita Natural Company

NORTH

WEST

EAST

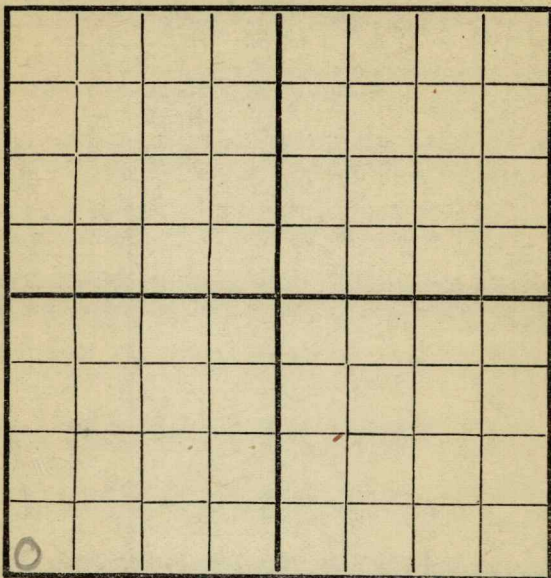

SOUTH

Location _____
 Rig Up _____
 Drilling and remarks

gas pay

1120-1147

producing
5m. gas.

RECORD

Cased _____ in. _____ Ft.
 Sand _____
 Gas _____
 Oil _____
 Total Depth _____

PRODUCTION

1st 24 hrs. Nat. _____
 1st 24 hrs. after shot _____
 Gas _____ Cu. Ft.
 Dry Hole _____
 Abandoned _____


Date

June 9, 1916 *H. Farnsworth* Scout

Map No. _____ Sec. 25 Twp. 27 R. 8
 Well No. 1 Lewis Farm _____
Wichita Nat Company _____

NORTH

WEST

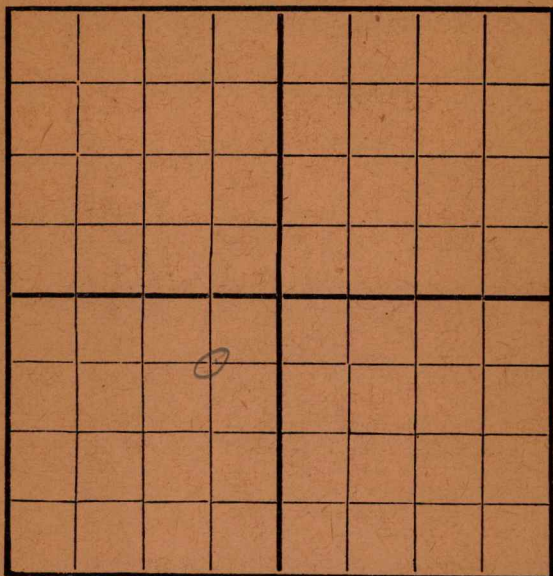

EAST

SOUTH

Location _____
 Rig Up _____
 Drilling and remarks _____

RECORD

Cased _____ in. _____ Ft.
 Sand _____
 Gas _____
 Oil _____
 Total Depth _____

PRODUCTION

1st 24 hrs. Nat. _____
 1st 24 hrs. after shot _____
 Gas _____ Cu. Ft.
 Dry Hole _____
 Abandoned _____

Date

12/14, 1916 Welford Scout


*bitting
 will start to
 pump in a
 few days.*

Map No. _____ Sec. 25 Twp. 27 R. 8Well No. 1 Lewis Farm _____Wichita Hall Company _____

NORTH

WEST

EAST

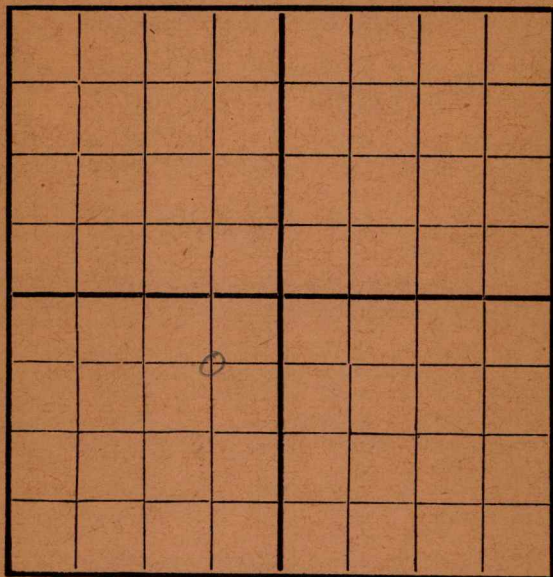

SOUTH

Location _____

Rig Up _____

Drilling and remarks _____

RECORD

Cased _____ in. _____ Ft.

Sand _____

Gas _____

Oil _____

Total Depth _____

PRODUCTION

1st 24 hrs. Nat. _____

1st 24 hrs. after shot _____

Gas _____ Cu. Ft.

Dry Hole _____

Abandoned _____

Date _____

12/22, 1916, Wichita Hall Scout


GREENWOOD COUNTY

Map No. _____ Sec. 25 Twp. 17 R. 8Well No. 1. Lewis Farm _____Wichita Nat. Company _____

NORTH

WEST

EAST

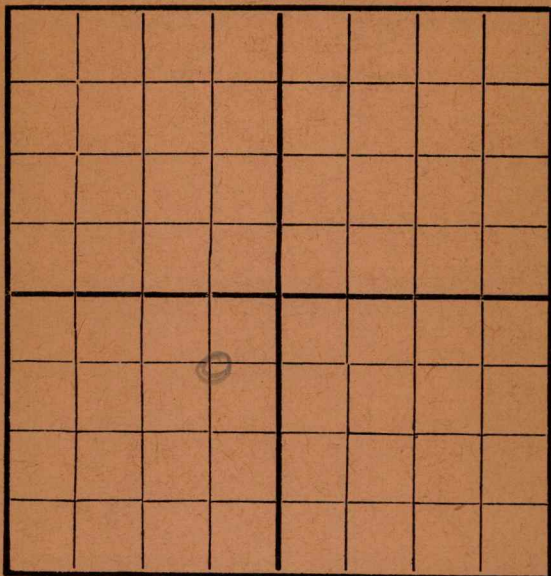

SOUTH

Location _____

Rig Up _____

Drilling and remarks

*S.D. for
roads.*

RECORD

Cased _____ in. _____ Ft.

Sand _____

Gas _____

Oil _____

Total Depth _____

PRODUCTION

1st 24 hrs. Nat. _____

1st 24 hrs. after shot _____

Gas _____ Cu. Ft.

Dry Hole _____

Abandoned _____

Date


12/25, 191 *6*, *Welford* Scout

Map No. 110 Sec. 25 Twp. 27 R. 8
 Well No. 1 Lewis Farm
Wichita Kan. Company

NORTH

WEST

EAST

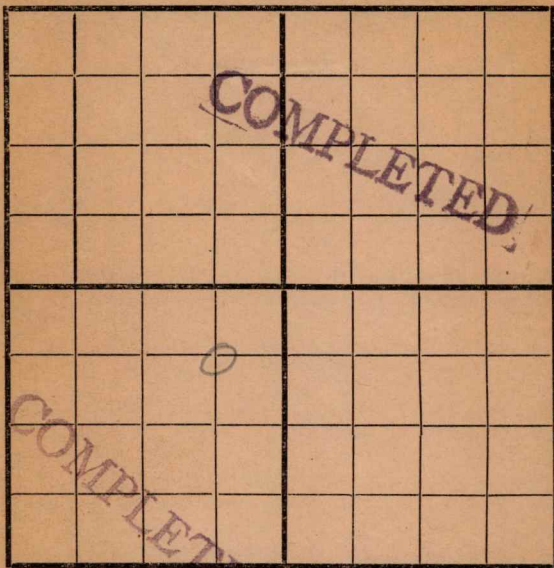

SOUTH

Location _____
 Rig Up _____
 Drilling and remarks _____

RECORD

Cased _____ in. _____ Ft.
 Sand 1827-1858
 Gas _____
 Oil _____
 Total Depth _____

PRODUCTION

1st 24 hrs. Nat. 54 BBL.
 1st 24 hrs. after shot _____
 Gas _____ Cu. Ft.
 Dry Hole _____
 Abandoned _____

Date

1/4, 1917 Wichita Scout