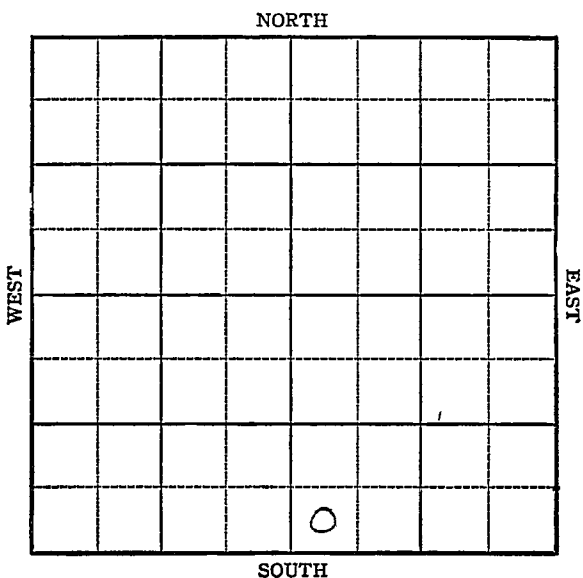


KANSAS

McPherson County

Section 6 Township 19 Range 1WWell No. #1 SmithCompany Barbara Oil

KANSAS

McPherson County

Sec. 6 Twp. 19 R. 1W

Well No. #1 Smith Farm

Barbara Oil Company

Ritz Canton

 Ft. from N. Line

330


 Ft. from S. Line

 Ft. from E. Line

330

 Ft. from W. Line

SW SE Elw. 1569

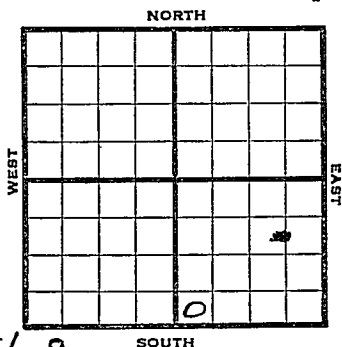

1944

R E P O R T

10/18

Rotary

10/25

8" @ 160

Drlg. 1660

11/1

Miss 2944

Drlg. 2950

11/8

TD 2979

5" @ 2965 RUST

11/16

2000' oil

11/24

8"@ 172 Drlg. 1852

11/29

2000 oil

12/6

500 accid .

Pump 140 bbls oil in 18 hrs.

12/14

" " " " " "

12/21

" " " " " "

12/27

" " " " " "

1945

1/3

" " " " "

1/10

" " " " "

1/17

" " " " "

1/26

" " " " "

1/31

" " " " "

2/7

Miss 2944

5" @ 2965

500 acid

TD 2979 Pump 224 Pot.

Grav. 36.0

COMPLETED

KANSAS

Pool Name Ritz CantonMap No. 43 Sec. 6 Twp. 19 R. 1WWell No. 1 SmithBarbara Oil

Company

FIRST REPORT

Contractor

SW SE

SECTION PLAT

Ft. from N. Line

330

Ft. from S. Line

Ft. from E. Line

330

Ft. from W. Line

McPherson

Location

Rig up

Drilling and Remarks:

Rotary

RECORD

Cased _____ in., _____ ft.

Sand _____

Gas _____

Oil _____

Total Depth _____

PRODUCTION

1st 24 hrs. Nat. _____

1st 24 hrs. after shot _____

Gas _____ Cu. Ft.

Dry Hole _____

Abandoned _____

Date

OCT 18 1944

19

S. J. LEWIS

Scout

Pool Name JerdayMap No. K-43 Sec. 6 Twp. 19 R. 1WWell No. 1 SmithBarbara Oil

Company

COMPLETED

Contractor

SW SE

SECTION PLAT

 Ft. from N. Line330 Ft. from S. Line Ft. from E. Line330 Ft. from W. LineMcPhersonLocation Rig up

Drilling and Remarks:

*Mis 2944**5" @ 2965**500000 C**Pump 124 BX**36° S*

RECORD

Cased in., ft.Sand Gas Oil Total Depth 2929

PRODUCTION

1st 24 hrs. Nat. 1st 24 hrs. after shot Gas Cu. Ft.Dry Hole Abandoned

Date

FEB 7 1945S. I. LEWIS Scout