


Cowley

Map No. *Kans* Sec. *19* Twp. *32* R. *3*

Well No. *2 Carson* Farm

J.B. Slick Company

NORTH

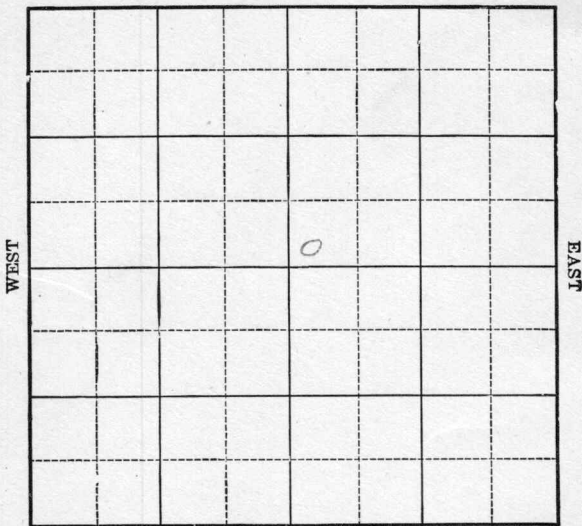

SOUTH

Location _____

Drilling Remarks

RECORD

Cased _____ in. _____ ft.

Sand _____

Gas _____

Oil _____

Total Depth _____

Rig Up _____

Drilling Remarks

PRODUCTION

1st 24 hrs. Nat. _____

1st. 24 hrs. after shot _____

Gas _____ cu. ft.

Dry Hole _____

Abandoned _____

Cowley

Map No. **KANSAS** Sec. *19* Twp. *32* R. *3*

Well No. *2 Carson*

T.B. Slick Company

Contractor

Twin to #1 will be a shallow sand well

SECTION PLAT

		o	

-----Ft. from N. Line

150 Ft. from S. Line

-----Ft. from E. Line

250 Ft. from W. Line

FIRST REPORT

Location -----

Rig up -----

Drilling and Remarks:

R. G.

RECORD

Cased ----- in., ----- ft.

Sand -----

Gas -----

Oil -----

Total Depth -----

PRODUCTION

1st 24 hrs. Nat. -----

1st 24 hrs. after shot -----

Gas ----- Cu. Ft.

Dry Hole -----

Abandoned -----

Date

1/14 3

M. A. BENEAR

192

Scout

Map No. **1** **KANSAS** Sec. **19** Twp. **32** R. **3**

Well No. **2 Carson**

J.B. Slick Company

Contractor

COMPLETED SECTION PLAT

----- Ft. from N. Line

150 Ft. from S. Line

----- Ft. from E. Line

250 Ft. from W. Line

		0	

Location -----

Rig up -----

Drilling and Remarks:

20/250 Mls.

RECORD

Cased ----- in., ----- ft.

Sand **2593-2613**

Gas -----

Oil -----

Total Depth **2613**

PRODUCTION

1st 24 hrs. Nat. -----

1st 24 hrs. after shot -----

Gas ----- Cu. Ft.

Dry Hole -----

Abandoned -----

Date

3/30 192**5**

M. A. BENEAR

Scout