


Map No. Kan Sec. 19 Twp. 32 R. 3 *Cawley*
 Well No. Carson Farm
L. B. Slick Company

NORTH

WEST

EAST

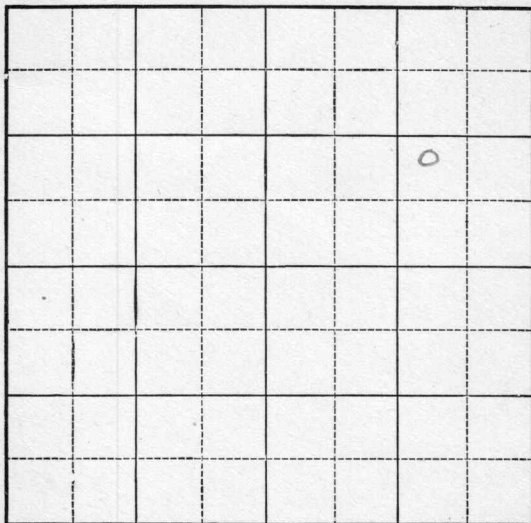

SOUTH

Location _____

Drilling Remarks _____

Rig Up _____

Drilling Remarks _____

RECORD

Cased _____ in. _____ ft.

Sand _____

Gas _____

Oil _____

Total Depth _____

PRODUCTION

1st 24 hrs. Nat. _____

1st. 24 hrs. after shot _____

Gas _____ cu. ft.

Dry Hole _____

Abandoned _____

KANSAS

Map No. _____ Sec. 19 Twp. 32 R. 3

Well No. 6 Carson

T. B. Slick Company

Contractor

FIRST REPORT

SECTION PLAT

_____ Ft. from N. Line

990 Ft. from S. Line

990 Ft. from E. Line

_____ Ft. from W. Line

			o

Location ✓✓

Rig up _____

Drilling and Remarks:

RECORD

Cased _____ in., _____ ft.

Sand _____

Gas _____

Oil _____

Total Depth _____

PRODUCTION

1st 24 hrs. Nat. _____

1st 24 hrs. after shot _____

Gas _____ Cu. Ft.

Dry Hole _____

Abandoned _____

Date

JUL 22 1925

M. A. BENEAR

_____ 192 _____ Scout

County *Cowley*
 Map No. *KANSAS* Sec. *19* Twp. *32* R. *3E*

Well No. *5 Carson*

T. B. Slick Company

First report showed Contractor

this well as No 6

it was then changed

to No 5

_____ Ft. from N. Line

990 Ft. from S. Line

990 Ft. from E. Line

_____ Ft. from W. Line

SECTION PLAT

			0

COMPLETED

Change from #6

Location *to #5*

Rig up _____

Drilling and Remarks:

T.S. 2595

B.B. 2611

263876 18/100

37.4 Gr.

RECORD

Cased _____ in., _____ ft.

Sand _____

Gas _____

Oil _____

Total Depth _____

PRODUCTION

1st 24 hrs. Nat. _____

1st 24 hrs. after shot _____

Gas _____ Cu. Ft.

Dry Hole _____

Abandoned _____

Date

Sept 16 1925

S. J. LEWIS

Scout