

Map No. Kansas Sec. 19 Twp. 32 R. 3


Well No. 3 Carson Farm
J. B. Slick Company

..... Ft. from N. Line

755 Ft. from S. Line

800 Ft. from E. Line

..... Ft. from W. Line

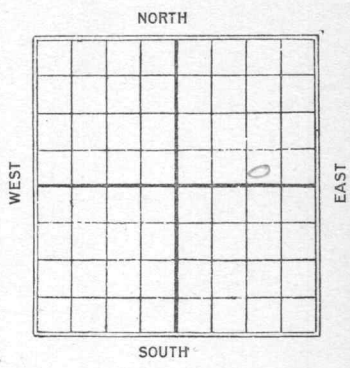

Beneas

Date
1925

REPORT

5/18

R. O. G.

6/5

640

7/5

2265

7/22

Sd. 2574-2602 swab

315 cbl 1st 24 hrs

Map No. KANSAS Sec. 19 Twp. 32 R. 3

Well No. 4 Carson

T B Slick Company

Contractor

SECTION PLAT

----- Ft. from N. Line

253 Ft. from S. Line

200 Ft. from E. Line

----- Ft. from W. Line

			0

FIRST REPORT

Location -----

Rig up -----

Drilling and Remarks:

R.O.G.

RECORD

Cased ----- in., ----- ft.

Sand -----

Gas -----

Oil -----

Total Depth -----

PRODUCTION

1st 24 hrs. Nat. -----

1st 24 hrs. after shot -----

Gas ----- Cu. Ft.

Dry Hole -----

Abandoned -----

Date

MAY 18 1925

192

Scout

M. A. BENEAR

X

Map No. _____ Sec. 19 Twp. 32 R. 3E

Well No. 3 Carson

T. B. Blisk Company

Contractor

Change #4 to #3 SECTION PLAT

_____ Ft. from N. Line

330 Ft. from S. Line

990 Ft. from E. Line

_____ Ft. from W. Line

			0

Correct this well from No 4 to No 3

Location _____

Rig up _____

Drilling and Remarks:

see files

RECORD

Cased _____ in., _____ ft.

Sand _____

Gas _____

Oil _____

Total Depth _____

PRODUCTION

1st 24 hrs. Nat. _____

1st 24 hrs. after shot _____

Gas _____ Cu. Ft.

Dry Hole _____

Abandoned _____

Date

10/5 1925 - Blisk Scout

Map No. KANSAS Sec. 19 Twp. 32 R. 3E

Well No. 4 Carson

T.B. Slick Company

Contractor

COMPLETED SECTION PLAT

----- Ft. from N. Line

355' Ft. from S. Line

800' Ft. from E. Line

----- Ft. from W. Line

			0

Location -----

Rig up -----

Drilling and Remarks:

sand
2574-2602
swapped
315-116/1st 24 hrs

RECORD

Cased ----- in., ----- ft.

Sand -----

Gas -----

Oil -----

Total Depth -----

PRODUCTION

1st 24 hrs. Nat. -----

1st 24 hrs. after shot -----

Gas ----- Cu. Ft.

Dry Hole -----

Abandoned -----

Date

JUL 22 1925

M. A. BENEAR

----- 192-----

----- Scout