


Map No. Kansas Sec. 19 Twp. 32 R. 3^E

Well No. 4 Carson Farm
F. B. Slick Company

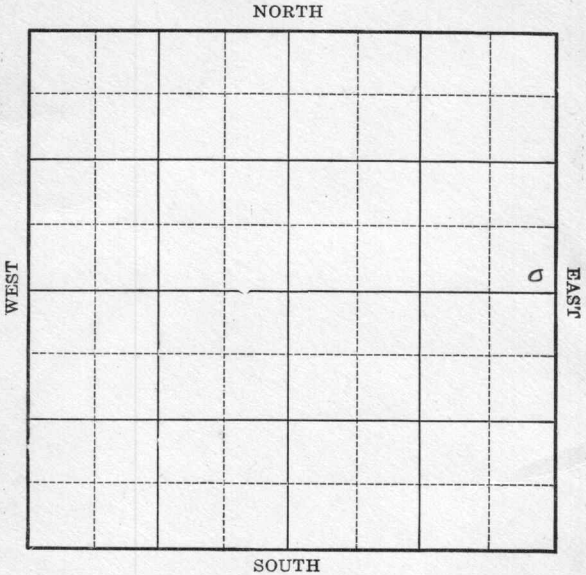

Location _____

Drilling Remarks _____

Rig Up _____

Drilling Remarks _____

RECORD

Cased _____ in. _____ ft.

Sand _____

Gas _____

Oil _____

Total Depth _____

PRODUCTION

1st 24 hrs. Nat. _____

1st 24 hrs. after shot _____

Gas _____ cu. ft.

Dry Hole _____

Abandoned _____

Map No. Raw Sec. 19 Twp. 32 R. 3E


Well No. 4 Carson Farm
T. B. Slick Company

_____ Ft. from N. Line

330 Ft. from S. Line

330 Ft. from E. Line

_____ Ft. from W. Line

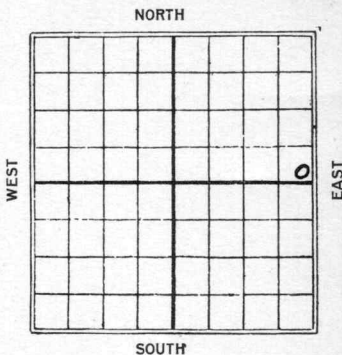

L

Date	REPORT
1935	
7/29	Spud
8/7	560'
8/14	1165'
8/19	1660'
8/27	1860'
9/12	1930 147. W.
9/19	2250'
9/16	Tap sand 2580' Oil 2596-2614 100' oil in hole
9/23	2580' oil 2596 TD. 2614 2611-14 Water Shock 10 gts 35 Bbls Oil 35 Bbls Water Swabbing

Map No. KANSAS Sec. 19 Twp. 32 R. 2E

Well No. H Carson

T. B. Slick Company

Contractor

FIRST REPORT

SECTION PLAT

----- Ft. from N. Line

330 Ft. from S. Line

330 Ft. from E. Line

----- Ft. from W. Line

			0

Location -----

Rig up -----

Drilling and Remarks:

Spudding

RECORD

Cased ----- in., ----- ft.

Sand -----

Gas -----

Oil -----

Total Depth -----

PRODUCTION

1st 24 hrs. Nat. -----

1st 24 hrs. after shot -----

Gas ----- Cu. Ft.

Dry Hole -----

Abandoned -----

Date

JUL 29 1925

192

T. B. Slick Scout

Cowley

Map No. **KANSAS** Sec. *19* Twp. *32* R. *3E*

Well No. *4 Carson*

T. B. Slick

Company

Contractor

SECTION PLAT

			0

----- Ft. from N. Line

330 Ft. from S. Line

320 Ft. from E. Line

----- Ft. from W. Line

COMPLETED

Location -----

Rig up -----

Drilling and Remarks:

MS 2580

Oil 2596

MS 2614

2611-2614 Water Sand

3108 10 qt.

3588 Oil

2588 Water

swatted.

Date

SEP 23 1925

192

RECORD

Cased ----- in., ----- ft.

Sand -----

Gas -----

Oil -----

Total Depth -----

PRODUCTION

1st 24 hrs. Nat. -----

1st 24 hrs. after shot -----

Gas ----- Cu. Ft.

Dry Hole -----

Abandoned -----

S. J. LEWIS

Scout