

Greenwood

KANSAS

Form 51-5M-1-30-38840

Map No. _____ Sec. *25* Twp. *27* R. *8*


Well No. *2-Lewis* Farm

Molder-Henderson Company

NORTH

WEST

EAST

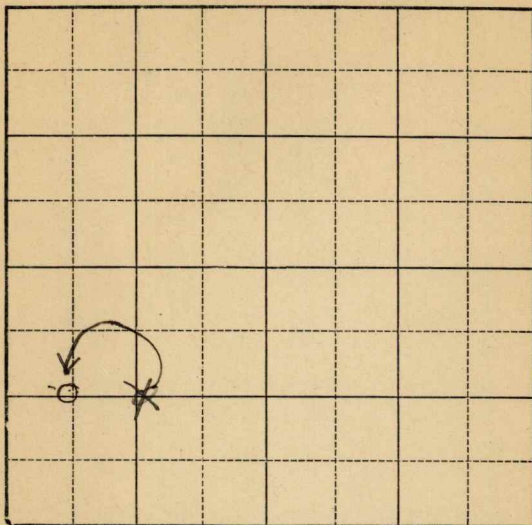

SOUTH

Location _____
Drilling Remarks _____

Rig Up _____
Drilling Remarks _____

RECORD
Cased _____ in. _____ ft.
Sand _____
Gas _____
Oil _____
Total Depth _____

PRODUCTION
1st 24 hrs. Nat. _____
1st 24 hrs. after shot _____
Gas _____ cu. ft.
Dry Hole _____
Abandoned _____

Greenwood

Map No. Kansas Sec. 25 Twp. 27 R. 8E


Well No. 2 Lewis Farm
Molder - + - Henderson Company

1320 Ft. from N. Line

_____ Ft. from S. Line

_____ Ft. from E. Line

660
~~1320~~ Ft. from W. Line

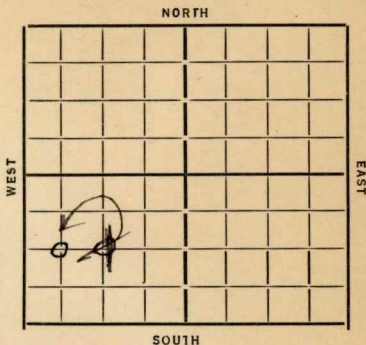

Date	REPORT
1933	
5/24	Drilling 380'
5/24	S.D. 500
6/1	—
6/18	—
6/15	—
6/21	Run 10" 800'
6/28	S.D. 900'
7/5	—
7/12	—
7/19	—
7/26	—
8/2	—
8/9	—
8/17	—
8/23	—
8/30	—
9/6	—
9/13	—
9/20	drlg 950
9/29	" 975
10/5	—
10/11	—
10/18	—
10/25	—
11/1	—

over

1933

11/8 Arly 975

11/15 — 11/22 — 11/29 —

12/6 — 12/13 — 12/27 —

1/11 — 1/17 —

1/24 C.O. at 1000'

1/31 SD 1000

2/4- 8" 1035

2/17- Arly 1095

2/23 TD 1129 SD

3/1 —

3/8 3 M Arly 1314

3/15 — 3/22 — 3/29 —

4/5 SD 1495

4/12 Arly 1530

4/19 " 1651

4/26 " 1670 6" 1645

5/3 " 1760

5/10 " 1800

5/18 TD 1830 s.o. acidizing

5/25 — 5/31 — 6/7 —

6/14 —

6/20 Sand 1800 TD 1832

12 bbl.

COMPLETED

10 KANSAS

Map No. _____ Sec. 25 Twp. 27 R. 8

Well No. 2 Lewis
Molder & Henderson Company

Contractor

FIRST REPORTS

1320 Ft. from N. Line

_____ Ft. from S. Line

_____ Ft. from E. Line

1320 Ft. from W. Line

SECTION PLAT

Location _____

Rig up _____

Drilling and Remarks:

By 380

RECORD

Cased _____ in., _____ ft.

Sand _____

Gas _____

Oil _____

Total Depth _____

PRODUCTION

1st 24 hrs. Nat. _____

1st 24 hrs. after shot _____

Gas _____ Cu. Ft.

Dry Hole _____

Abandoned _____

Date

MAY 10 1933

CHAS. L. SHERWOOD

192

Scout

Greenwood

E

Map No. **KANSAS** Sec. *25* Twp. *27* R. *8*

Well No. *2 Lewis*

Molder & Henderson Company

Contractor

SECTION PLAT

CORRECTION

1320 Ft. from N. Line

..... Ft. from S. Line

..... Ft. from E. Line

660 Ft. from W. Line

Location.....

Rig up.....

Drilling and Remarks:

*Chy location
to above.*

RECORD

Cased.....in.,ft.

Sand.....

Gas.....

Oil.....

Total Depth.....

PRODUCTION

1st 24 hrs. Nat.....

1st 24 hrs. after shot.....

Gas.....Cu. Ft.

Dry Hole.....

Abandoned.....

Date

MAY 2 4 1933 CHAS. L. SHERWOOD


192

Scout

Thomas & Henderson drilled &
completed a gas well at these
ft measurements in 1931

C. P. Kuhn

check AND advise
Sam

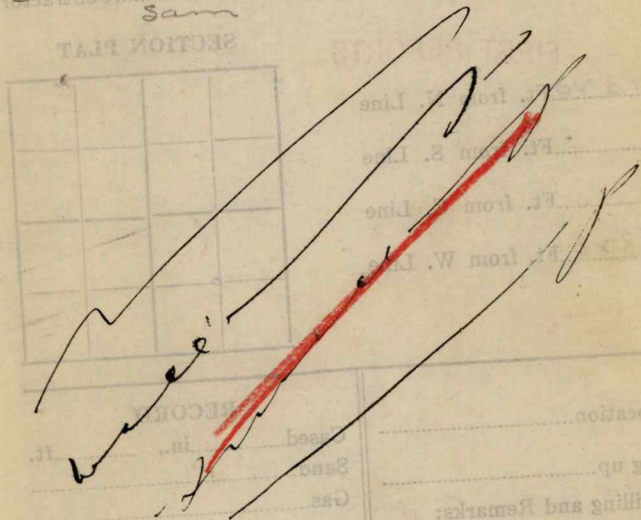

Returned _____
Cards _____
Tracing _____
France Map _____
Scarborough Map _____
Moody Map _____
Scarborough Plat Book _____
Moody Plat Book _____

Returned _____
Cards _____
Tracing _____
France Map _____
Scarborough Map _____
Moody Map _____
Scarborough Plat Book _____
Moody Plat Book _____

KANSAS

Map No. 10 Sec. 25 Twp. 27 R. 8EWell No. 2 - LewisMolden & Henderson Company

Contractor

COMPLETED

SECTION PLAT

1320 Ft. from N. Line

_____ Ft. from S. Line

_____ Ft. from E. Line

660
1320 Ft. from W. Line

Location _____

Rig up _____

Drilling and Remarks:

12 bbb

RECORD

Cased _____ in., _____ ft.

Sand 1800

Gas _____

Oil _____

Total Depth 1832

PRODUCTION

1st 24 hrs. Nat. _____

1st 24 hrs. after shot _____

Gas _____ Cu. Ft.


Dry Hole _____

Abandoned _____

Date

6-20-37 19ORVAL MANN SCHRECK
Scout

check location
advised
Sun

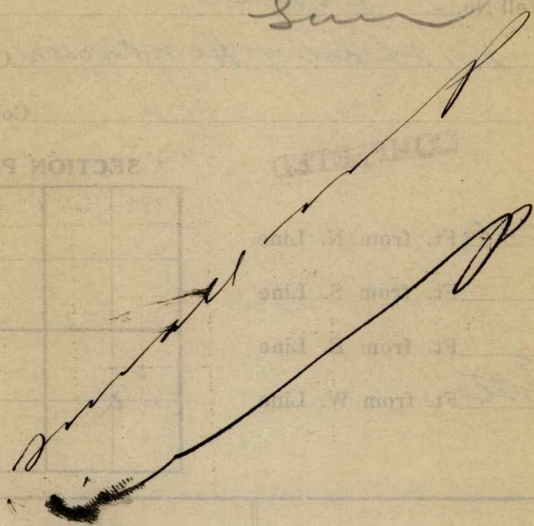

Returned	RSB
Cards	RSB
Tracing	RSB
France Map	RSB
Scarborough Map	RSB
Moody Map	RSB
Scarborough Plot Book	RSB
Moody Plot Book	RSB