


Map No. Kansas Sec. 19 Twp. 32 R. 3

Well No. 27 Carson Farm

J. B. Stick Company

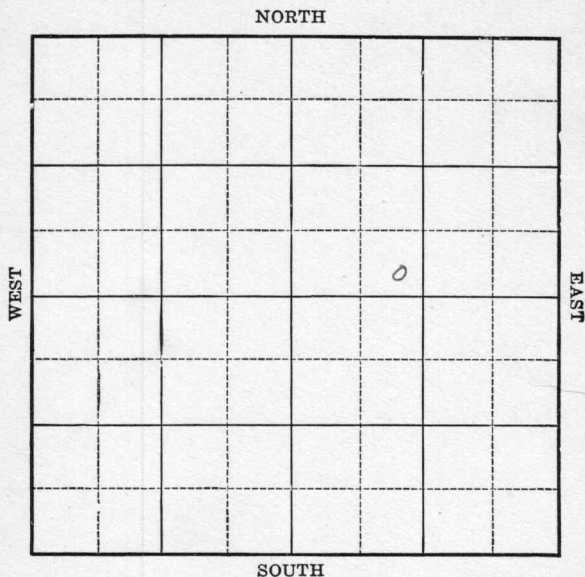

Location _____

Drilling Remarks

RECORD

Cased _____ in. _____ ft.

Sand _____

Gas _____

Oil _____

Total Depth _____

Rig Up _____

Drilling Remarks

PRODUCTION

1st 24 hrs. Nat. _____

1st. 24 hrs. after shot _____

Gas _____ cu. ft.

Dry Hole _____

Abandoned _____

Cowley

Map No. *Kansas* Sec. *19* Twp. *32* R. *3*

Well No. *(2-A) Carson* Farm


J.B. Slick Company

990 Ft. from N. Line

_____ Ft. from S. Line

330 Ft. from E. Line

_____ Ft. from W. Line

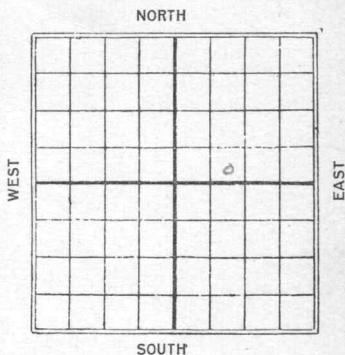

Date


REPORT

1925

3/1 Location

5/15 Taps 2585 TD 2602 230 bbl nat.

1 **KANSAS** Sec. 19 Twp. 32 R. 3 *Cawley*
 Well No. (2A) *Curson* Farm
J.B. Slick Company
990 x 330 N

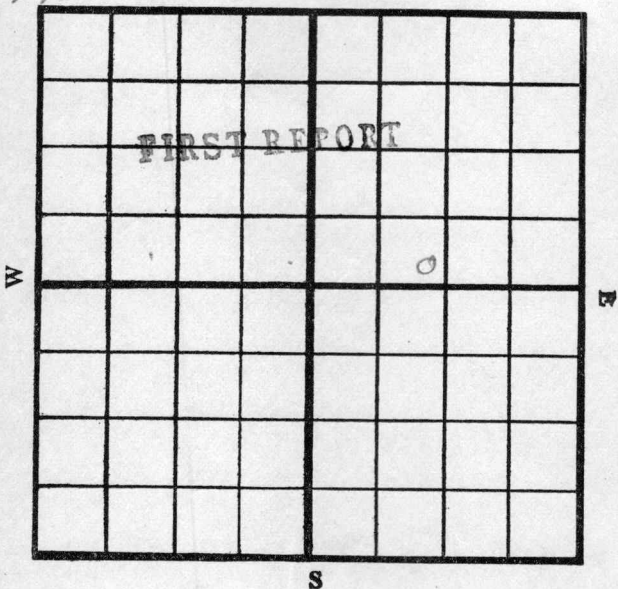

Location *✓✓*
 Rig up
 Drilling and Remarks

RECORD
 Casedin.....ft.
 Sand.....
 Gas.....
 Oil.....
 Total Depth.....

PRODUCTION
 1st 24 hrs. Nat.....
 1st 24 hrs. after Shot.....
 Gascu. ft.
 Dry Hole.....
 Abandoned

Date *3/1* 19*5*
M. A. BENEAR Scout

Map No. Sec. 19 Twp. 32 R. 3

Well No. (2) H/Carson (now 2B)

T.B. Slick Company

Contractor

No changed to (2B)

SECTION PLAT

_____ Ft. from N. Line

330 Ft. from S. Line

_____ Ft. from E. Line

990 Ft. from W. Line

COMPLETED

Location _____

Rig up _____

Drilling and Remarks:

Topo. 2585
Pay 2593-2602 27.0

230 H/6770h

RECORD

Cased _____ in., _____ ft.

Sand _____

Gas _____

Oil _____

Total Depth _____

PRODUCTION

1st 24 hrs. Nat. _____

1st 24 hrs. after shot _____

Gas _____ Cu. Ft.

Dry Hole _____

Abandoned _____

Date

MAY 16 1925

M. A. BENEAROM

_____ 192_____

Scout