


Map No. _____ Sec. 25 Twp. 27 R. 8
Well No. 3 Lewis Farm
Empire Company

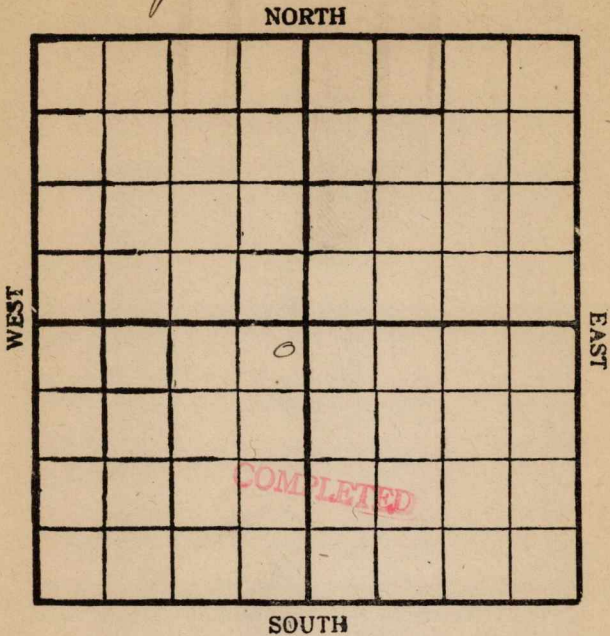

Location _____

Drilling Remarks:

Rig Up _____

Drilling Remarks:

RECORD

Cased _____ in. _____ ft.

Sand _____

Gas _____

Oil _____

Total Depth _____

PRODUCTION

1st 24 hrs. Nat. _____

1st 24 hrs. after shot _____

Gas _____ cu. ft.

Dry Hole _____

Abandoned _____

Map No. K10 Sec. 23 Twp. 27 R. 8Well No. 3 LewisEmpire


Company

Contractor

NORTH

WEST

EAST

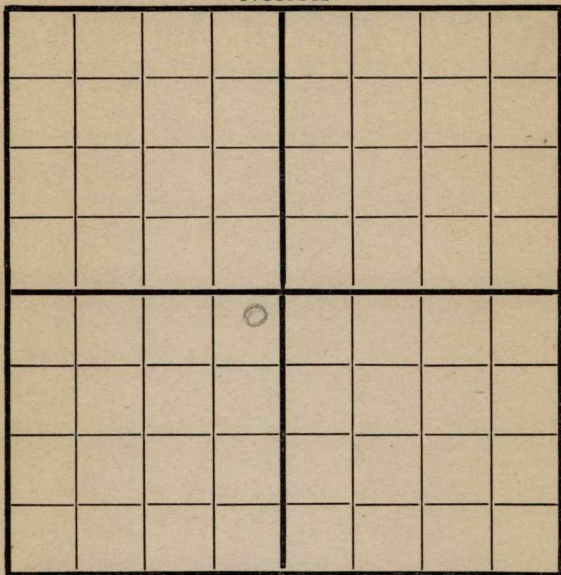264 N-E SOUTH

Location _____

Rig up _____

Drilling and Remarks:

425'

RECORD

Cased _____ in., _____ ft.

Sand _____

Gas _____

Oil _____

Total Depth _____

PRODUCTION

1st 24 hrs. Nat. _____

1st 24 hrs. after shot _____

Gas _____ Cu. Ft.

Dry Hole _____

Abandoned _____

Date

3/71919

Pyle

Scout

Form 26—14 BOOKS OF 100 SHEETS EACH—4-15-18

Map No. K10 Sec. 23 Twp. 27 R. 8

Well No. 3 Lewis

Empire Company

Contractor

NORTH

WEST

EAST

264 N-E SOUTH

Location _____

Rig up_____

Drilling and Remarks:

Set 12 1/2 @
790

RECORD

Cased _____ in., _____ ft.

Sand

Gas _____

Oil _____

Total Depth.....

PRODUCTION

1st 24 hrs. Nat. -----

1st 24 hrs. after shot-----

Gas.....Cu. Ft.

Dry Hole.....

Abandoned _____

Date _____

Date 2/12 1919 Pyle Scout

Map No. 110 Sec. 25 Twp. 27 R. 8

Well No. 3 S. C. Lewis

Empire

Company

Contractor

NORTH

WEST

EAST

9

264 N-E

SOUTH

Location _____

Rig up

Drilling and Remarks:

1050

10" hole

RECORD

Cased _____ in., _____ ft.

Sand_____

Gas _____

Oil _____

Total Depth_____

PRODUCTION

1st 24 hrs. Nat. -----

1st 24 hrs. after shot-----

Gas.....Cu. Ft.

Dry Hole

Abandoned.....

Date _____

191 9

Pyle

Scout

2

Map No. R10 Sec. 23 Twp. 27 R. 8

Well No. 3 W. O. Lewis

Company

Contractor

NORTH

WEST

EAST

SOUTH

Location _____

Rig up_____

Drilling and Remarks:

RECORD

Cased 10 in., 1050 ft.

Sand

Gas _____

Oil _____

Total Depth_____

PRODUCTION

1st 24 hrs. Nat. _____

1st 24 hrs. after shot-----

Gas_____Cu. Ft.

Dry Hole

Abandoned.....

Date _____

191 9.

Scout

130.5

Form 26—1M Books of 100 Sheets Each—4-15-18

Map No. K10 Sec. 25 Twp. 27^s R. 8E

Well No. 3 Lewis

Empire _____ Company

_____ Contractor

NORTH

WEST

EAST

SOUTH

264 N-E

RECORD

Location _____

Cased _____ in., _____ ft.

Rig up-----

Sand _____

Drilling and Remarks:

Gas -----

Oil _____

Total Depth.....

PRODUCTION

1st 24 hrs. Nat. -----

1st 24 hrs. after shot-----

Gas _____ Cu. Ft.

Dry Hole

Abandoned.....

Date _____

191.

Pyle

Scott

3/7


Map No. K10 Sec. 25 Twp. 27 R. 8 EWell No. 3 LewisEmpire Company

Contractor

NORTH

WEST

EAST

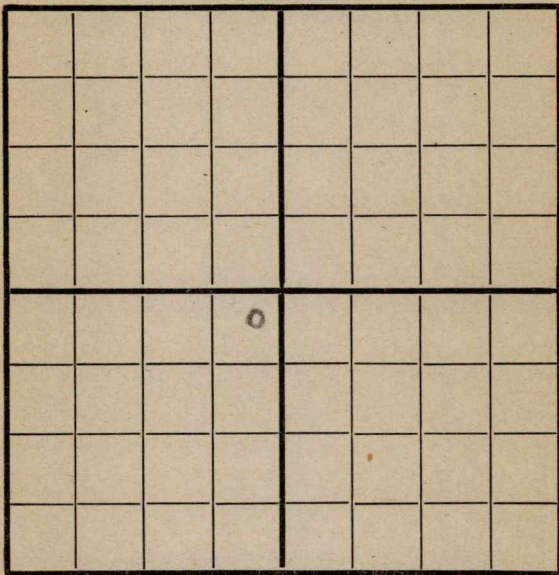264 N-E SOUTH

Location _____

Rig up _____

Drilling and Remarks:

1119 1690'

RECORD

Cased _____ in., _____ ft.

Sand _____

Gas _____

Oil _____

Total Depth _____

PRODUCTION

1st 24 hrs. Nat. _____

1st 24 hrs. after shot _____

Gas _____ Cu. Ft.

Dry Hole _____

Abandoned _____

Date

3/12 1919Pyle Scout


Map No. K 10 Sec. 25 Twp. 27 R. 8Well No. 3 LewisEmpire Company

Contractor

NORTH

WEST

EAST

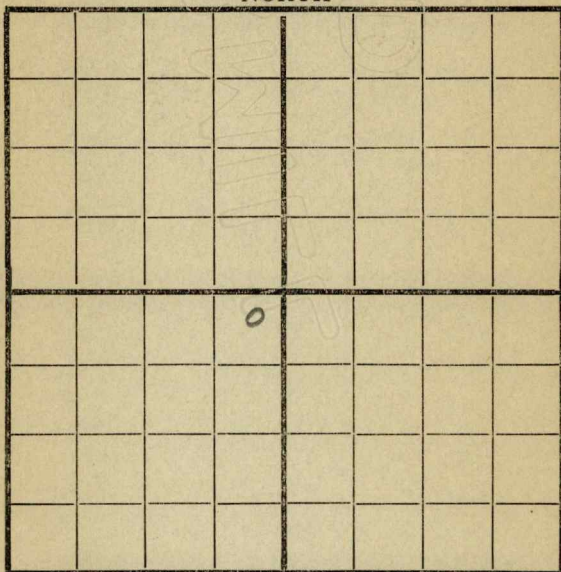

SOUTH

264 N-E

Location _____

Rig up _____

Drilling and Remarks:

RECORD

Cased _____ in., _____ ft.

Sand _____

Gas _____

Oil _____

Total Depth _____

PRODUCTION

1st 24 hrs. Nat. _____

1st 24 hrs. after shot _____

Gas _____ Cu. Ft.

Dry Hole _____

Abandoned _____

Date


3/18 1919**Pyle**

Scout

Map No. K10 Sec. 25 Twp. 27 R. 8
 Well No. 3 Lewis
Empire Company
 Contractor

NORTH

WEST

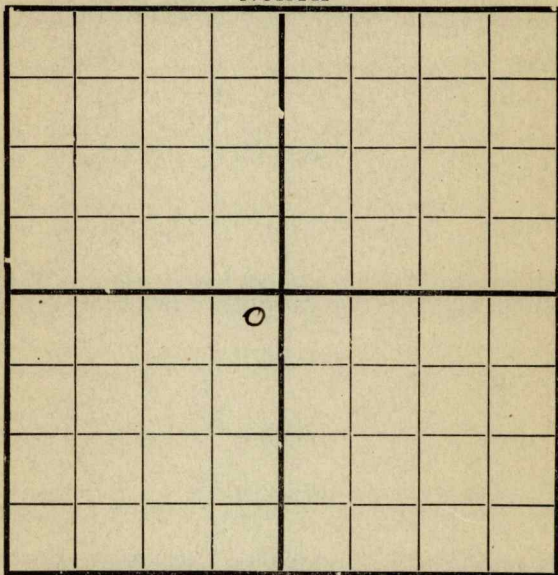

EAST

264 N-E SOUTH

Location _____

Rig up _____

Drilling and Remarks:

*cleaning
out @
1837*

RECORD

Cased _____ in., _____ ft.

Sand _____

Gas _____

Oil _____

Total Depth _____

PRODUCTION

1st 24 hrs. Nat. _____

1st 24 hrs. after shot _____

Gas _____ Cu. Ft.

Dry Hole _____

Abandoned _____

Date

Pyle

191

Scout

3/27


Map No. K10 Sec. 25 Twp. 27 R. 8Well No. 3 Lewis
Empire Company

Contractor

NORTH

WEST

EAST

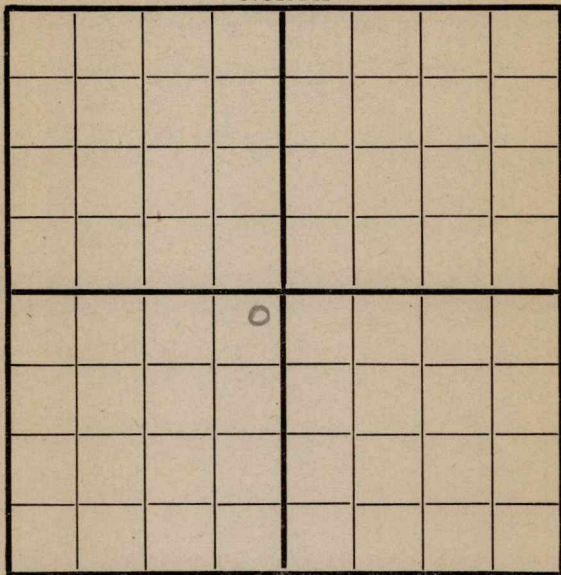

SOUTH

264 N-E

Location _____

Rig up _____

Drilling and Remarks:

D 10 @
1837

RECORD

Cased _____ in., _____ ft.

Sand _____

Gas _____

Oil _____

Total Depth _____

PRODUCTION

1st 24 hrs. Nat. _____

1st 24 hrs. after shot _____

Gas _____ Cu. Ft.

Dry Hole _____

Abandoned _____

Date

4/4
1919

Pyle

Scout

Map No. K10 Sec. 25 Twp. 27 R. 8

Well No. 3 Lewis

Empire Company

Contractor

NORTH

WEST

EAST

SOUTH

264 N.E

Location _____

Rig up_____

Drilling and Remarks:

800' oil in
hole.

RECORD

Cased _____ in., _____ ft.

Sand 1824-1835

Gas _____

Oil _____

Total Depth_____

PRODUCTION

1st 24 hrs. Nat. _____

1st 24 hrs. after shot_____

Gas.....Cu. Ft.

Dry Hole.....

Abandoned.....

Date _____

$\frac{4}{8}$ 1919

Pyle


Scout

Map No. K10 Sec. 25 Twp. 27 R. Well No. 3 LewisEmpireCor Contr

NORTH

WEST

EAST

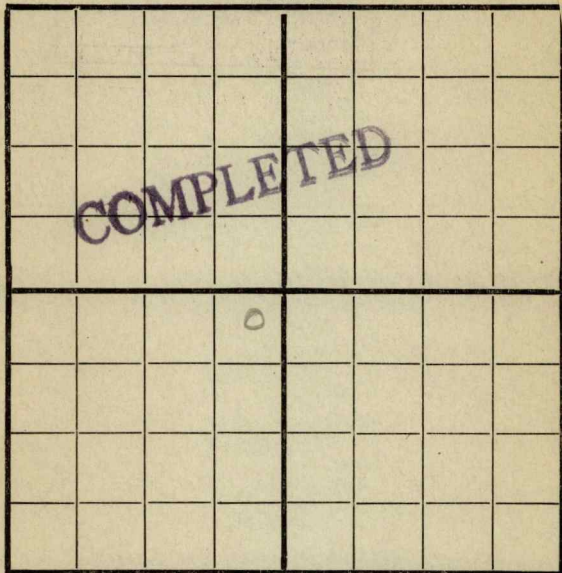

SOUTH

264 N-E

RECORD

Location Cased in., ft.Rig up Sand 1824-1835

Drilling and Remarks:

Gas Oil Total Depth

PRODUCTION

1st 24 hrs. Nat. 30 bbls1st 24 hrs. after shot Gas Cu. Ft.Dry Hole Abandoned

Date

4/16 1919

Scout