

Section 25 Township 27 Range 8EWell No. #27 LewisCompany K. T. Weidemann

NORTH

WEST

EAST

C

SOUTH

Greenwood

KANSAS

Sec. 25 Twp. 27 R. 8E

Well No. #27 Lewis Farm

K. T. Weidemann Company

Contractor


Ft. from N. Line

330' Ft. from S. Line

990' Ft. from E. Line

Ft. from W. Line

SW SE SW

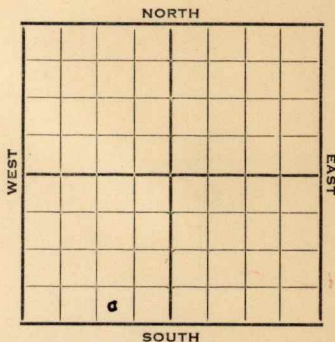

1952

Elev. -

REPORT

2/20

Pru Sand 1822

TD 1823

5" @ 1823

WOC

3/19

Oil well TD 1847'

Prue Sand 1822'

TD 1823' 5" @ 1823' DD 1847'

Hydro. Comp. 15 BOPD

COMPLETED

County Greenwood State Kansas

Sec. **25** (Blk.) **27** (Sur.) **8E** Map No.

Operator **K. T. Weidemann**

Well No. 27 Farm Lewis

Elev.	Location	SW	SE	SW

1st. Report **FEB 20 1952**

Completion

Remarks

Spudding Date _____

Drlg. Data

Pru sand 1822	TD 1823	5" @ 1823
---------------	---------	-----------

WO C

J. G. McGEHEE

County Greenwood State KansasSec. 25 (Blk. Twp.) 27 (Sur. Rge.) 8E Map No. _____Operator K. T. WeidemannWell No. 27 Farm LewisElev. _____ Location SW SE SW330 Ft. From S Line SW990 Ft. From E Line Quarter

1st. Report _____

Completion MAR 19 1952

Remarks _____

Spudding Date _____

Drilg. Data Oil well TD 1847Pru sand 1822 TD 1823 5" @ 1823DD 1847 Hydro. Comp. 15 bopd

J. G. McGEHEE