


Section 25 Township 27 Range 8E

Well No. #28 Lewis

Company K. T. Weidemann

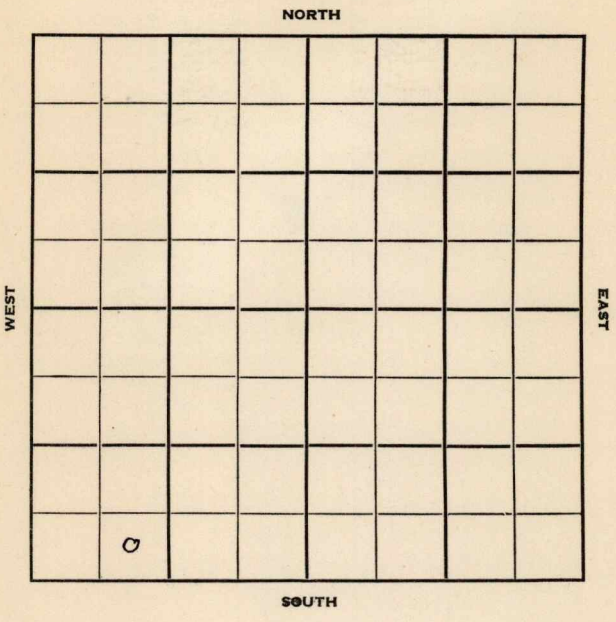

Greenwood

KANSAS

Sec. **25** Twp. **27** R. **8E**

Well No. **#28 Lewis** Farm

K. T. Weidemann Company

Contractor

Ft. from N. Line


330'

Ft. from S. Line

Ft. from E. Line

990'

Ft. from W. Line

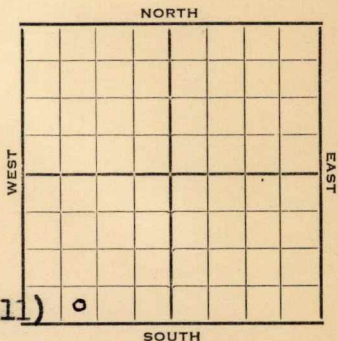

SE SW SW (Twin Well) ○

1952

Elev. -

REPORT

2/20

Drlg. 1575'

3/19

Oil well TD 1847' **KC 1675'**

Prue sand 1821' 5" @ 1823' TD 1847'

Hydro. Comp. 15 BOPD

COMPLETED

