


Section 25 Township 27 Range 8E
Well No. 36 Lewis
Company K. T. Weidemann

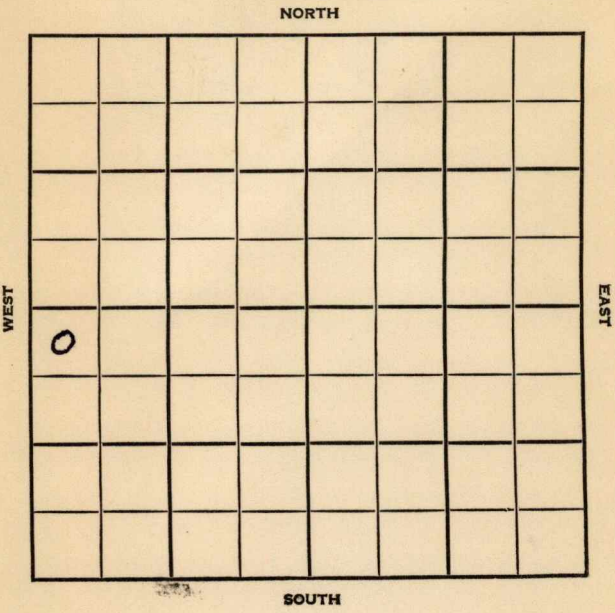

Greenwood KANSAS

SEC.	TWP.	R.
25	27	8E

WELL NO.

36 Lewis

FARM

COMPANY

K. T. Weidemann

CONTRACTOR


Weidemann

330 Ft. from N. Line

Ft. from S. Line

Ft. from E. Line

330 Ft. from W. Line

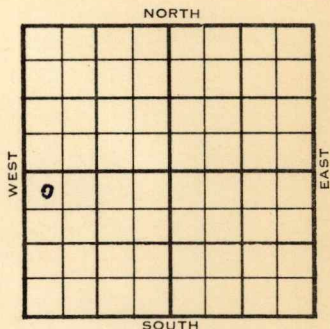

NW NW SW

1954

ELEVATION

REPORT

8/4

Location

8-18

Oil well

TD 2494

10" @ 41

KC 1697 BKC 1862 Cherokee sh. 2186

Miss. 2467

TD 2478

5" @ 2478

DD 2494 1000 A Comp. 25 bopd

COMPLETED

County **Greenwood** State **Kans.**

Sec. **25** (Blk.) **27** (Sur.) **8E** Map No.

Operator **K. T. Weidemann**

Well No. **36** Farm **Lewis**

[illegible]

330 Ft. From N Line SW

330 Ft. From W Line Quarter

1st. Report AUG 4 1954

Completion

Remarks

Weidemann - Contr.

Spudding Date _____

Drlg. Data

Location

J. G. McGEHEE

FABEN GILSTRAP