


FORM 51

Section 19 Township 32 Range 3E

Well No. #4 Waite

Company A.D. Allison

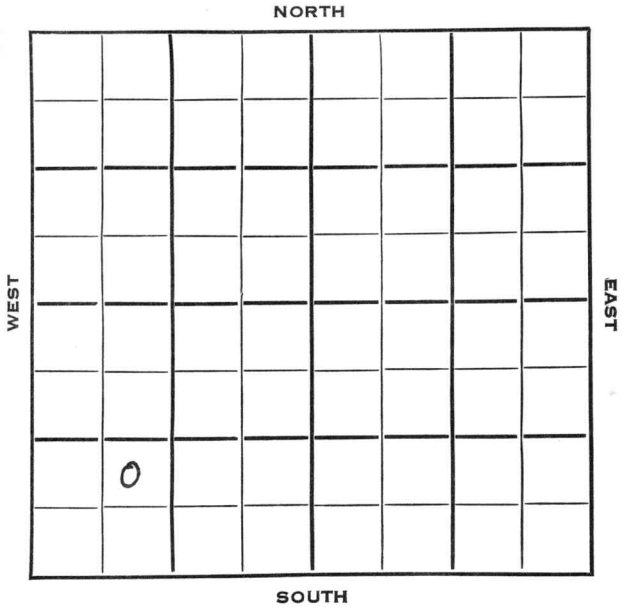

Cowley

KANSAS

SEC. 19	TWP. 32	R. 3 E ✓
------------	------------	-------------

WELL NO. # 4 Waite FARM

COMPANY

CONTRACTOR A. D. Allison

Watson


Slick-Carson Pool

_____ Ft. from N. Line

990 _____ Ft. from S. Line

_____ Ft. from E. Line

990 _____ Ft. from W. Line

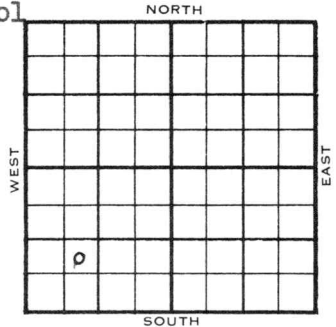

NE SW SW

1954	ELEVATION 1141'	REPORT
------	--------------------	--------

1/20 Spud 1-16-54
8" @ 88
Drlg. 494'

2/3 Spud 1-16-54
D & A
TD 3167'
8" @ 88'
KC 2660', Bart 3096', Bart. Sd. 3107'
Miss 3152'
TD 3167'
D & A

ABANDONED

County Cowley State Kansas

Sec. 19 (Blk. Twp.) 32 (Sur. Rge.) 3E Map No.

Operator A. D. Allison

Well No. 4 Farm Waite

Elev. 1141 Location NE SW SW

ABANDONED									

990 Ft. From S Line SW

990 Ft. From W Line Quarter

1st. Report

Completion FEB 3 1954

Remarks Slick-Carson Pool

Watson - Contr.

Spudding Date 1-16-54

Drig. Data D & A TD 3167

8" @ 88 KC 2660 Bart. 3096

Bart. sd. 3107 Miss. 3152 TD 3167

D & A