


Section 25 Township 27 Range 8E

Well No. #23 Lewis (A)

Company K. T. Weideman

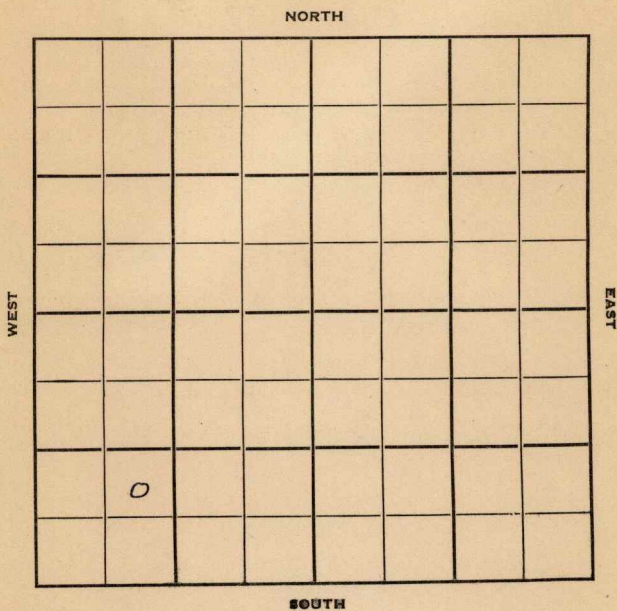

Greenwood

KANSAS

Sec. 25 Twp. 27 R. 8E

Well No. #23 Lewis (A) Farm

K. T. Weideman Company

Contractor

Ft. from N. Line

990


Ft. from S. Line

Ft. from E. Line

990

Ft. from W. Line

NE SW SW (twin well).

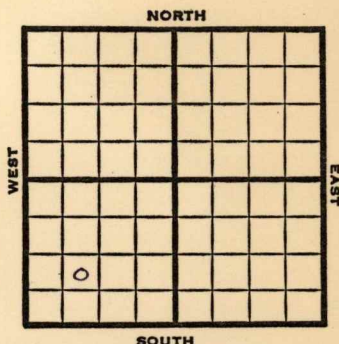

1951

Elev. -

REPORT

10/10

Spud 10-5-51
10" @ 62'
Drlg. 1500'

12/5

Spud 10-5-51
Oil well TD 1850' 10" @ 62'
KC 1685' Prue 1820'
7" @ 1830' TD 1850' Hydro.
Comp. 15 BOPD

COMPLETED

County Greenwood State KansasSec. 25 (Blk. Twp.) 27 (Sur. Rge.) 8E Map No. _____Operator K. T. WeidemannWell No. 23 Farm Lewis "A"Elev. _____ Location NE SW SW (twin well)

990 Ft. From S Line SW990 Ft. From W Line Quarter

1st. Report _____

Completion DEC 5 1951

Remarks _____

Spudding Date 10-5-51Drilg. Data Oil well TD 185010" @ 62 KC 1685 Prue 1820 7" @ 1830TD 1850 Hydro. Comp. 15 bopd

J. E. TYRA

County Greenwood State KansasSec. 25 (Blk. 27) (Sur. 8E) Map No. 27Operator K. T. WeidemanWell No. 23 Farm Lewis (A)Elev. 990 Location NE SW SW (twin well)

990 Ft. From S Line SW990 Ft. From W Line QuarterIst. Report OCT 10 1951Completion Remarks Spudding Date 10-5-51Drlg. Data

10" @ 62' Drlg. 1500

J. E. TYRA