

Map No. **KANSAS** Sec. **19** Twp. **32^S** R. **3^E**

Well No. **3 A - Carson** Farm
J B Shirk Company

NORTH

(Carson)

WEST

EAST

							?
							0

SOUTH

Location.....

Drilling Remarks

.....

.....

Rig Up.....

Drilling Remarks

.....

.....

RECORD

Cased..... in..... ft.

Sand.....

Gas.....

Oil.....

Total Depth.....

PRODUCTION

1st 24 hrs. Nat.....

1st 24 hrs. after shot.....

Gas..... cu. ft.....

Dry Hole.....

Abandoned.....

Map No. Sec. Twp. R.

Well No. Farm


..... Company

..... Ft. from N. Line

..... Ft. from S. Line

..... Ft. from E. Line

..... Ft. from W. Line

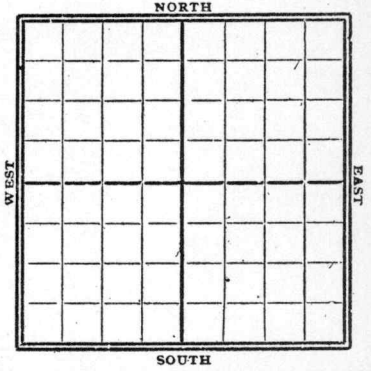

1926

Date

REPORT

Gypsy Records

2/1

*Abd TD 1440'
Skidded rig.*

MAP NO. _____ SEC. 19 TWP. 37S R. 3E

WELL NO. 34. Parson
J. B. Slick COMPANY

CONTRACTOR _____

SECTION PLAT

			0

_____ FT. FROM N. LINE
 _____ FT. FROM S. LINE
 _____ FT. FROM E. LINE
 _____ FT. FROM W. LINE

RECORD

LOCATION _____

CASED _____ IN. _____ FT.

RIG UP _____

SAND _____

DRILLING AND REMARKS:

GAS _____

Skidding
075

OIL _____

TOTAL DEPTH 1440

PRODUCTION

1ST 24 HRS. NAT. _____

1ST 24 HRS. AFTER SHOT _____

GAS _____ CU. FT.

DRY HOLE

ABANDONED

DATE

2/1 1926

SCOUT