

Cowley - KANSAS

8-24 16529

Map No. ~~O.W.D.D.~~ Sec. 19 Twp. 32 R. 3E

Well No. #4 CARTER, Waite Farm

~~Call~~ SINCCLAIR O & G. Company


Smitherman - Contr. NORTH

930
~~440~~ Ft. from N. Line

Ft. from S. Line

Ft. from E. Line

150
~~330~~ Ft. from W. Line

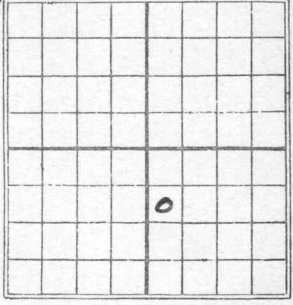

SWNWSE

Date 1925 REPORT

3/24 Reg up
 5/15 Sand 2621-24 120 bbl of nat.
 10 bbls water

1955 ~~O.W.D.D.~~ O.W.D.D

7/20 DD 3549' 5" @ 3548 DD 3595'
 7 GWPH PB 3552 4/3522-23 wtr.
 PB 3502' 4/2478-79, wtr. PB 3470
 4/3464-65 wtr. PB 3452 4/3449-50
 13 GWPH PB 3440 24/3430-36, dry.
 300 A. 3 BO 66 BWPH PB 3100
 42/3083-90 17 GWPH 200 A S/32.5
 BO 18 BW 24 hrs.
 Completed for 32 BOPD & 18 BW.

FIRST REPORT COMPLETED

Map No. **KANSAS** Sec. 19 Twp. 32 R. 2

Well No. 4 *Watts*
Carter Oil

Company

Contractor

FIRST REPORT

SECTION PLAT

990' Ft. from N. Line

_____ Ft. from S. Line

_____ Ft. from E. Line

330' Ft. from W. Line

		o	

Location _____

Rig up ✓✓

Drilling and Remarks:

RECORD

Cased _____ in., _____ ft.

Sand _____

Gas _____

Oil _____

Total Depth _____

PRODUCTION

1st 24 hrs. Nat. _____

1st 24 hrs. after shot _____

Gas _____ Cu. Ft.

Dry Hole _____

Abandoned _____

Date

3/24 1925

M. A. BENEAR

Scout

KANSAS

Map No. _____ Sec. 19 Twp. 32 R. 3

Well No. (4 or 3A) waito

Carter oil Company

Contractor _____

COMPLETED SECTION PLAT

990 Ft. from N. Line

_____ Ft. from S. Line

_____ Ft. from E. Line

330 Ft. from W. Line

Location _____

Rig up _____

Drilling and Remarks:

Sand 2621-2624

120 lbs Nat

10 lbs water

RECORD

Cased _____ in., _____ ft.

Sand _____

Gas _____

Oil _____

Total Depth _____

PRODUCTION

1st 24 hrs. Nat. _____

1st 24 hrs. after shot _____

Gas _____ Cu. Ft.

Dry Hole _____

Abandoned _____

Date

MAY 16 1925

M. A. BENEAR

192

Scout

~~O.W.D.D.~~

~~O.W.D.D.~~

O. W. D. D

FORM 513 REV. SUNRAY

County Cowley Elev. _____
 Sec. 19 Twp. 32 Rge. 3E
 Company Sinclair O & G
 Farm Name Carter-Waite No. 4

TOPS	DEPTH	LOG	DATUM
Anh.			
Tp.			
H. <u>Clave</u>	<u>2806</u>		
Tr. <u>Oswego</u>	<u>2873</u>		
Dg. <u>Cherokee</u>	<u>2992</u>		
Bl. <u>Bart</u>	<u>3074</u>		
L.			
K.C.			
B.K.C.			
Ce.			
C.			
M.	<u>3118</u>		
M.			
K.	<u>3344</u>		
Mz.			
Ma.			
V. <u>Chatta</u>	<u>3390</u>		
S.			
S.	<u>3429</u>		
A.	<u>3439</u>		
R.			
PE.			
G.			
T.D.	<u>3549</u>		

Loc. in Sec. _____
 SW NW SE
 930' NL
 150' WL
 Geol. _____
 Contr. _____
 Smitherman
 Pool
 Carson

FIRST REPORT
 JUL 20 '57
 0
 COMPLETE

Date Comm. _____
 DD 3549 5" @ 3548 DD 3595 7 gwph
 PB 3552 4/ 3522-23 wtr. PB 3502
 4/ 2478-79 wtr. PB 3470 4/ 3464-65
 wtr. PB 3452 4/ 3449-50 13 gwph
 PB 3440 24/ 3430-36 dry 300 A
 3 bo 66 bwph PB 3100 42/ 3083-90
 17 gwph 200 A S/ 32.5 bo 18 bw 24 hr.
 Comp. 32 bo pd 18 bw

Co.
Lse.
No.
Sec.
T.
R.