

Section 19 Township 32 Range 3E

Well No. #1 Conrad

Company L.C. Smitherman

NORTH

0							

WEST

EAST

SOUTH

Sec. 19 Twp. 32 R. 3E

Well No. #1 Conrad Farm

L.C. Smitherman Company

Gross Contractor


Ft. from N. Line

990 Ft. from S. Line

Ft. from E. Line

330 Ft. from W. Line

NW SW NW

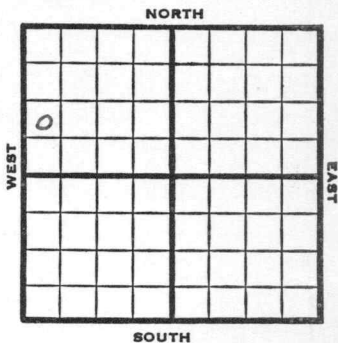

1953

REPORT

7/14

8" @ 107'
 Bart 3164
 Core 3168-78, Miss 3178
 RTD 3198
 D & A

FIRST REPORT

✓
ABANDONED

County Cowley State Kansas

Sec. 19 (Blk. Twp.) 32 (Sur. Rge.) 3E Map No.

Operator L. C. Smitherman

Well No. 1 Farm Conrad

Elev. _____ Location NW SW NW

990 Ft. From S Line NW

330 Ft. From W Line Quarter

Ist. Report JUL 14 1953

Completion JUL 14 1953

Remarks 7-5-53

~~Gross-Contr.~~

Spudding Date _____

Drilg. Data

8" @ 107 Bart 3164, Core 3168-78, Miss 3178
RTD 3198 D&A

J. G. McGEHEE

County Cowley State KansasSec. 19 (Blk.
Twp.) 32 (Sur.
Rge.) 3E Map No.Operator L. C. SmithermanWell No. 1 Farm ConradElev. Location NW SW NW990 Ft. From S Line NW330 Ft. From W Line Quarter

1st. Report

Completion JUL 22 1953

Remarks

Gross Drlg. - Contr.Spudding Date 7-5-53Drlg. Data D & A TD 31988" @ 107 Bart. 3164 Miss. 3178TD 3198D & A